

REGISTERED SURVEYOR'S CERTIFICATION

It is certified that the locations, levels and dimensions of the infrastructure shown here are a true representation of the constructed works and that the as-constructed survey was performed to the prescribed accuracy standards.

Registered Surveyors Name: Stephen Keily
 (Authorised Delegate) Registration Number: 6338

Registered Surveyors signature: *Steph Keily*
 Company Title: Brisbane Survey Group Pty. Ltd. Date: 08/09/2021

AS-CONSTRUCTED WORKS

IT IS CERTIFIED THAT WORKS HEREIN HAVE BEEN CONSTRUCTED TO RELEVANT APPROVED SPECIFICATIONS AND THE OPERATIONAL WORKS CONSTITUTE A TRUE AND CORRECT RECORD OF THE WORKS CONSTRUCTED AND COMPLY WITH THE DESIGN INTENT.

DATE OF PRACTICAL COMPLETION: 08/09/2021
 PROJECT NO: 20361-1-SEWER
 COMPANY TITLE: LAWSON SURVEYS
 NOTE: ALL AS-CONSTRUCTED INFORMATION SHOWN IN RED AND DOTTED WITH AN 'X'.

SCALE:	1:250
DATE:	AHD
DATE OF SURVEY:	29/09/2021
SURVEYED BY:	LAWSON SURVEYS
DRAWN BY:	QSD
CLIENT:	URBEX
ISSUE:	A
PLAN REFERENCE:	20361-1-SEWER
SHEET:	4 OF 4


OPW NUMBER:	REDLAND CITY COUNCIL
LOA:	VICTORIA POINT
SUBURGE:	MCA
ORIGIN:	
PLAN OF AS CONSTRUCTED SEWER	
CLAY GULLY STAGE 1	
CLAY GULLY ROAD, VICTORIA POINT	

Amendments	
ISSUE	DATE
A	11/10/2021
DETAILS	
REVISION	

LAWSON SURVEYS
 A.S.N. 46 272 940 047
 CONSULTING LAND SURVEYORS
 98/102 BISHOP STREET
 BRISBANE QLD 4000
 Ph: 07 3352 3328 Fax: 07 3352 8991
 email: lawson@lawson-surveys.com.au
 www.lawson-surveys.com.au



Scale: 1:250 — Lengths are in Metres.

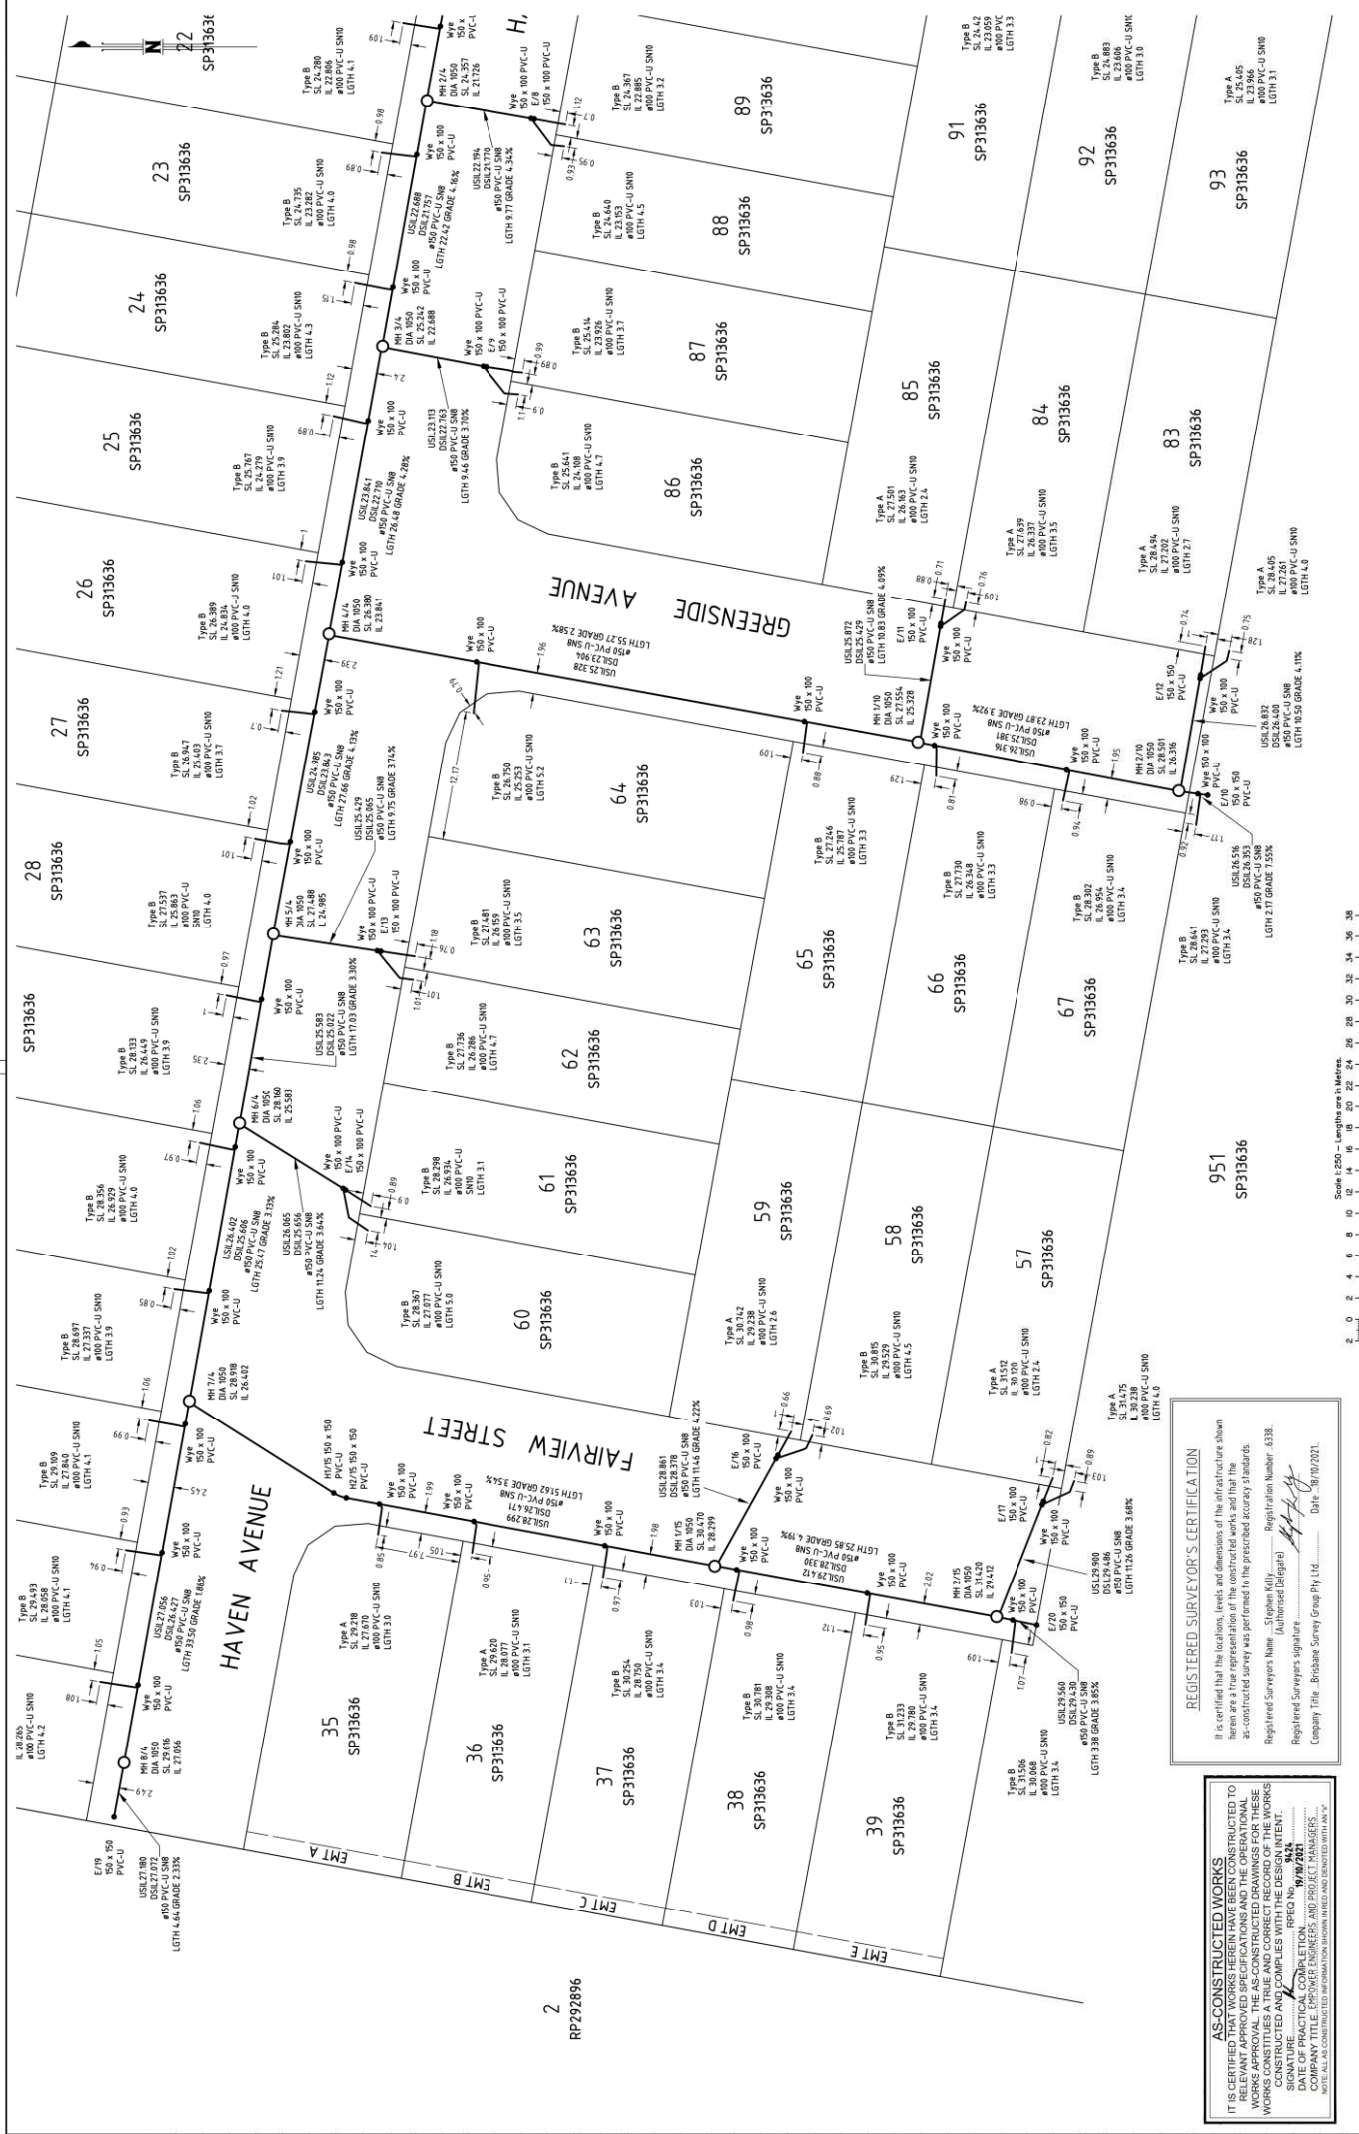


<p>AS-CONSTRUCTED WORKS</p> <p>IT IS CERTIFIED THAT THE LOCATIONS, LEVELS AND DIMENSIONS OF THE INFRASTRUCTURE SHOWN ON THESE DRAWINGS HAVE BEEN VERIFIED BY A REGISTERED SURVEYOR IN ACCORDANCE WITH THE SURVEY ACT 1988 (VIC) AND THE SURVEY REGULATIONS 2013 (VIC). THE SURVEY WAS CONDUCTED ON 20/09/2021.</p> <p>REGISTERED SURVEYORS NAME: Stephen Kelly Registration Number: 6338 REGISTERED SURVEYORS SIGNATURE: [Signature] Date: 30/09/2021 COMPANY TITLE: Brisbane Survey Group Pty Ltd</p>		<p>SCALE: 1:250</p> <p>DATE: AHD</p> <p>DATE OF SURVEY: 20/09/2021</p> <p>SUBMITTED BY: LAWSON SURVEYS</p> <p>DRAWN BY: QSD</p>	<p>CLIENT: URBEX</p> <p>PLAN REFERENCE: 20361-1-SEWER</p>	<p>ISSUE: A</p> <p>SHEET: 3 OF 4</p>	
<p>PLAN OF AS CONSTRUCTED SEWER</p> <p>CLAY GULLY STAGE 1</p> <p>CLAY GULLY ROAD, VICTORIA POINT</p>		<p>OPW NUMBER: REDLAND CITY COUNCIL</p> <p>LOA: VICTORIA POINT</p> <p>ORIGIN: MGA</p>	<p>SCALE: 1:250</p> <p>DATE: AHD</p> <p>DATE OF SURVEY: 20/09/2021</p> <p>SUBMITTED BY: LAWSON SURVEYS</p> <p>DRAWN BY: QSD</p>	<p>CLIENT: URBEX</p> <p>PLAN REFERENCE: 20361-1-SEWER</p>	<p>ISSUE: A</p> <p>SHEET: 3 OF 4</p>

LAWSON SURVEYS
 A.S.M. 46 272 940 047
 CONSULTING LAND SURVEYORS
 98 / 102 BISHOP STREET
 MELBOURNE VIC 3000
 Ph 07 3302 3326 Fax 07 3302 6991
 msl@lawsonsurveys.com.au
 www.lawsonsurveys.com.au

REGISTERED SURVEYOR'S CERTIFICATION
 It is certified that the locations, levels and dimensions of the infrastructure shown herein are a true representation of the constructed works and that the as-constructed survey was performed to the prescribed accuracy standards.
 Registered Surveyors Name: Shekhar Bhatia (Authorized Delegate) Registration Number: 6338
 Registered Surveyors Signature: [Signature] Date: 08/10/2021
 Company Title: Brisbane Survey Group Pty Ltd.

AS-CONSTRUCTED WORKS
 IT IS CERTIFIED THAT WORKS HEREIN HAVE BEEN CONSTRUCTED TO THE SPECIFICATIONS AND STANDARDS OF THE RELEVANT AUTHORITY. THESE WORKS APPROVAL, THE AS-CONSTRUCTED DRAWINGS FOR THESE WORKS CONSTITUTE A TRUE AND CORRECT RECORD OF THE WORKS CONSTRUCTED AND COMPLY WITH THE DESIGN INTENT.
 REGISTERED SURVEYOR'S NAME: SHEKHAR BHATIA
 COMPANY TITLE: EMPLOYER, ENGINEER, AND PROJECT MANAGER
 DATE OF PRACTICAL COMPLETION: 07/10/2021
 NOTE: ALL AS-CONSTRUCTED INFORMATION SHOWN IN RED AND DERIVED WITH AN 'X'.

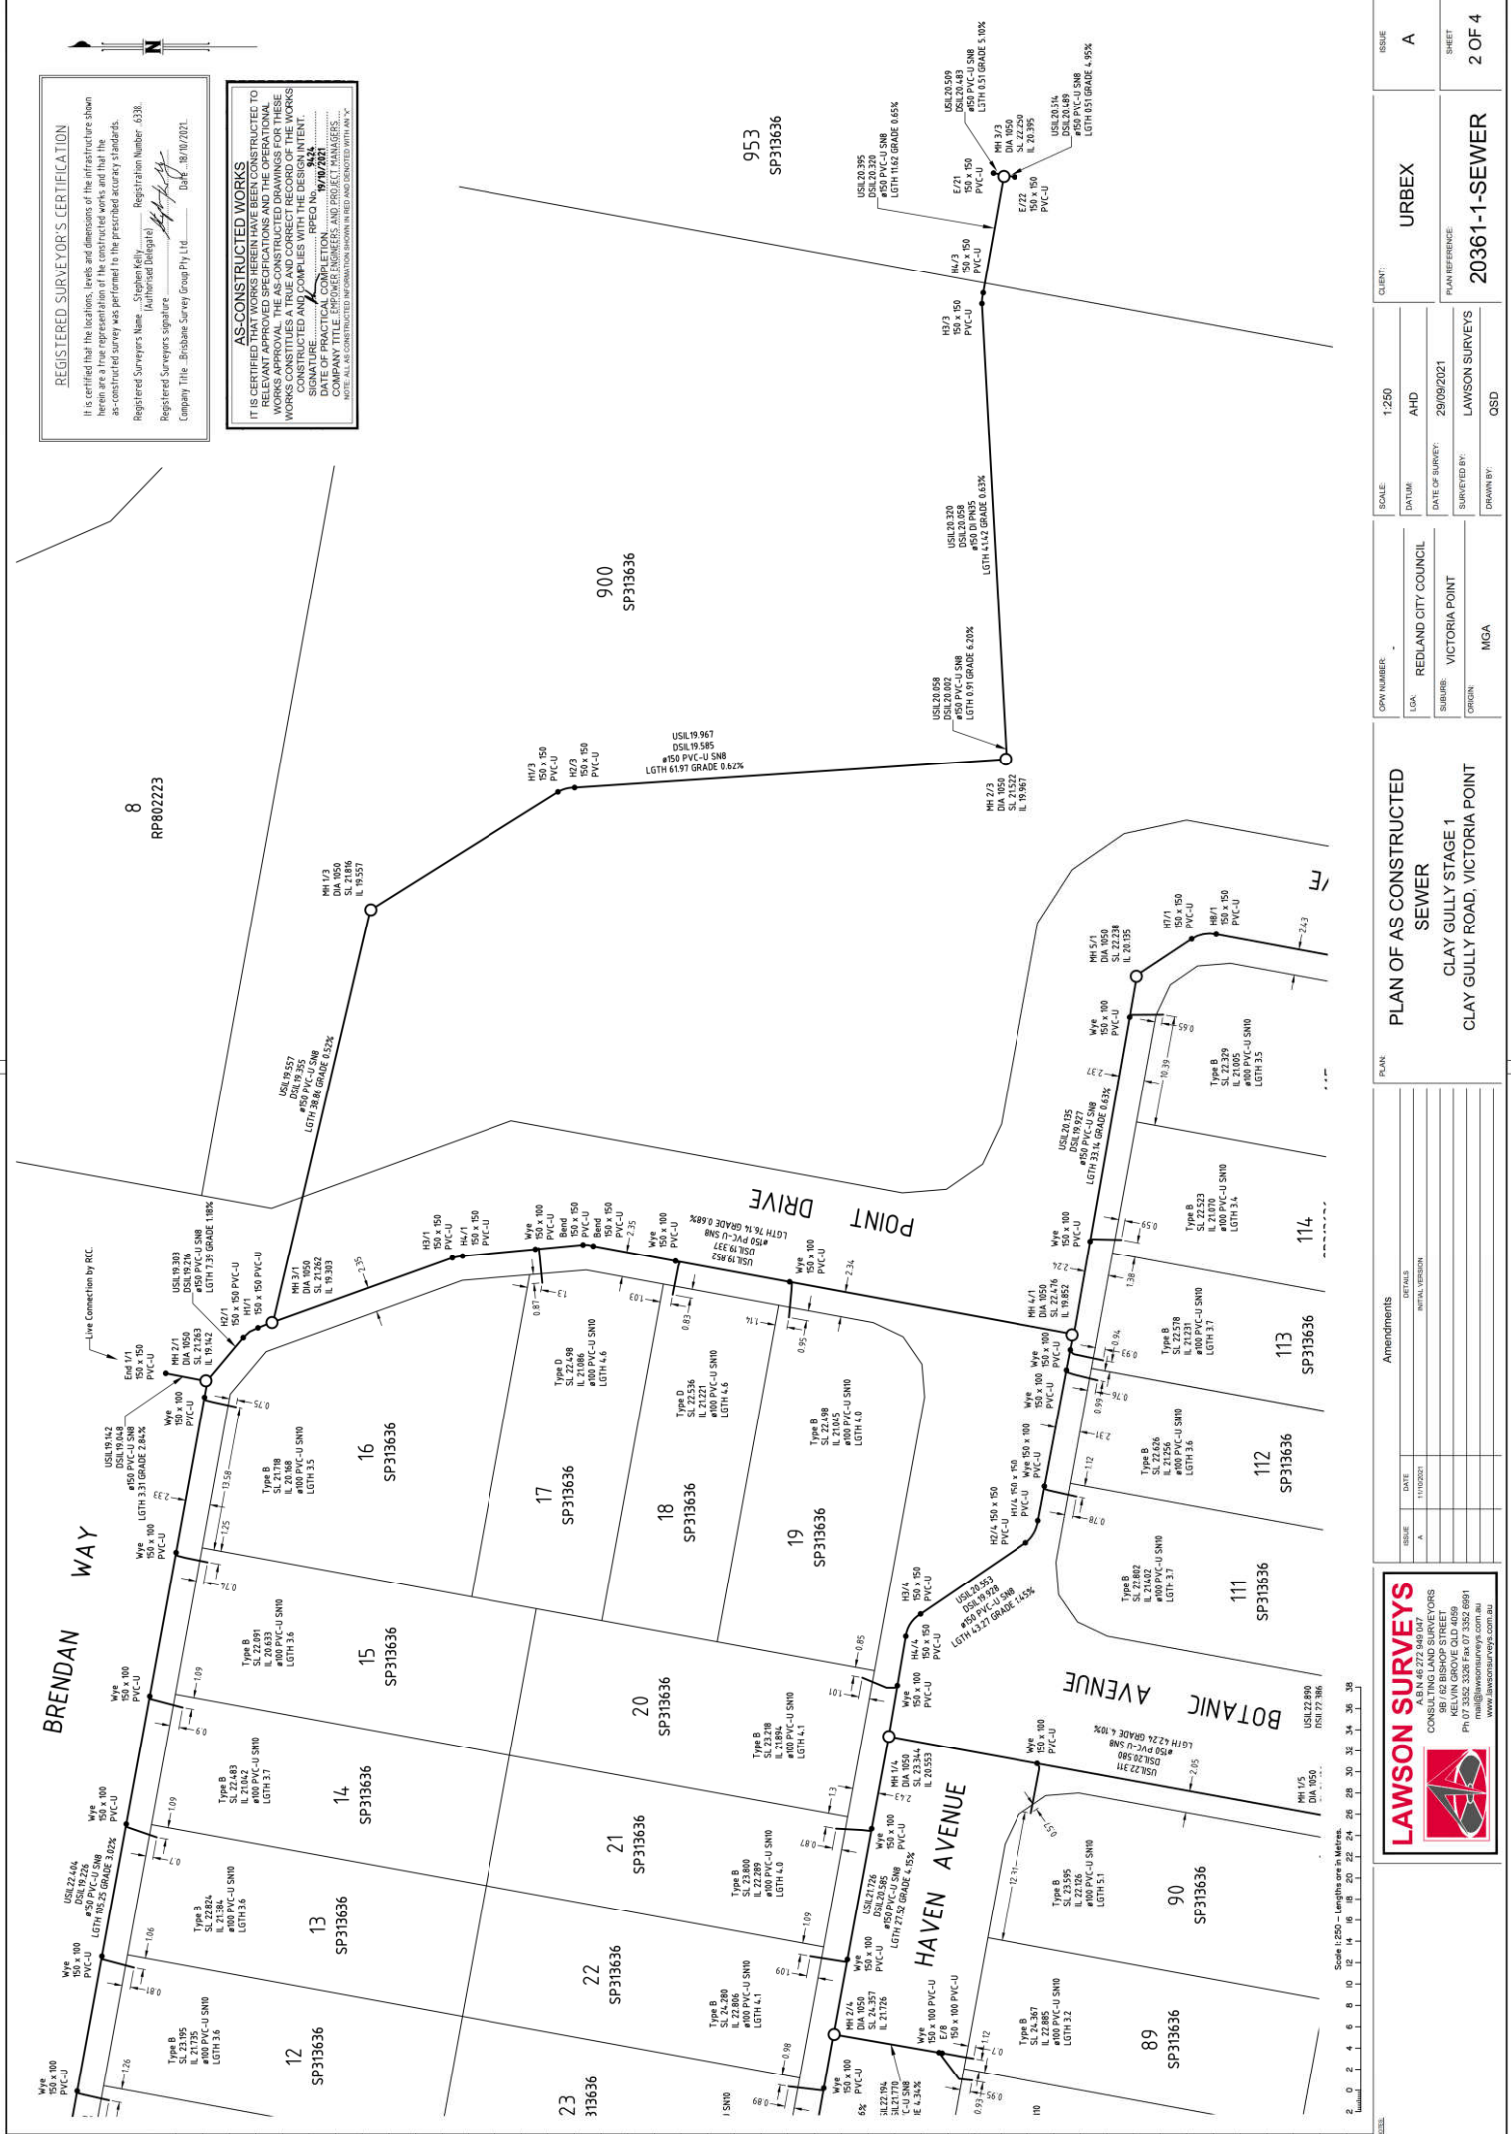

SCALE:	1:250
DATE:	AHD
DATE OF SURVEY:	29/09/2021
SURVEYED BY:	LAWSON SURVEYS
DRAWN BY:	QSD

OPW NUMBER:	REDLAND CITY COUNCIL
LOA:	VICTORIA POINT
SUBURGE:	MCA
ORIGIN:	


CLIENT: URBEX
 PLAN REFERENCE: 20361-1-SEWER
 SHEET: 2 OF 4

PLAN:	PLAN OF AS CONSTRUCTED SEWER
STAGE:	CLAY GULLY STAGE 1
LOCATION:	CLAY GULLY ROAD, VICTORIA POINT
AMENDMENTS:	
ISSUE:	A
DATE:	11/10/2021
DETAILS:	INITIAL VERSION

LAWSON SURVEYS
 A.S.M. 46 272 940 047
 CONSULTING LAND SURVEYORS
 98/102 BISHOP STREET
 BRISBANE QLD 4000
 PH: 07 3352 3326 FAX: 07 3352 6991
 email@lawsonsurveys.com.au
 www.lawsonsurveys.com.au

AS-CONSTRUCTED WORKS
 IT IS CERTIFIED THAT WORKS HEREIN HAVE BEEN CONSTRUCTED TO THE SPECIFICATIONS AND STANDARDS SET OUT IN THE AS-CONSTRUCTED DRAWINGS FOR THESE WORKS. APPROVAL OF THE AS-CONSTRUCTED DRAWINGS FOR THESE WORKS CONSTITUTES A TRUE AND CORRECT RECORD OF THE WORKS CONSTRUCTED AND COMPLIES WITH THE DESIGN INTENT. THE DATE OF PRACTICAL COMPLETION OF THESE WORKS IS 10/10/2021. COMPANY TITLE: EMPLOYER, ENGINEER, AND PROJECT MANAGERS. DATE: 10/10/2021. (SIGNED BY: PROJECT MANAGER) DATE: 10/10/2021. (SIGNED BY: PROJECT MANAGER)

REGISTERED SURVEYOR'S CERTIFICATION
 It is certified that the locations, levels and dimensions of the infrastructure shown herein are a true representation of the constructed works and that the as-constructed survey was performed to the prescribed accuracy standards. Registered Surveyors Name: Stephen Kelly (Authorized Delegate) Registration Number: 6338. Registered Surveyors signature: [Signature] Date: 10/10/2021. Company Title: Brobbins Survey Group Pty Ltd

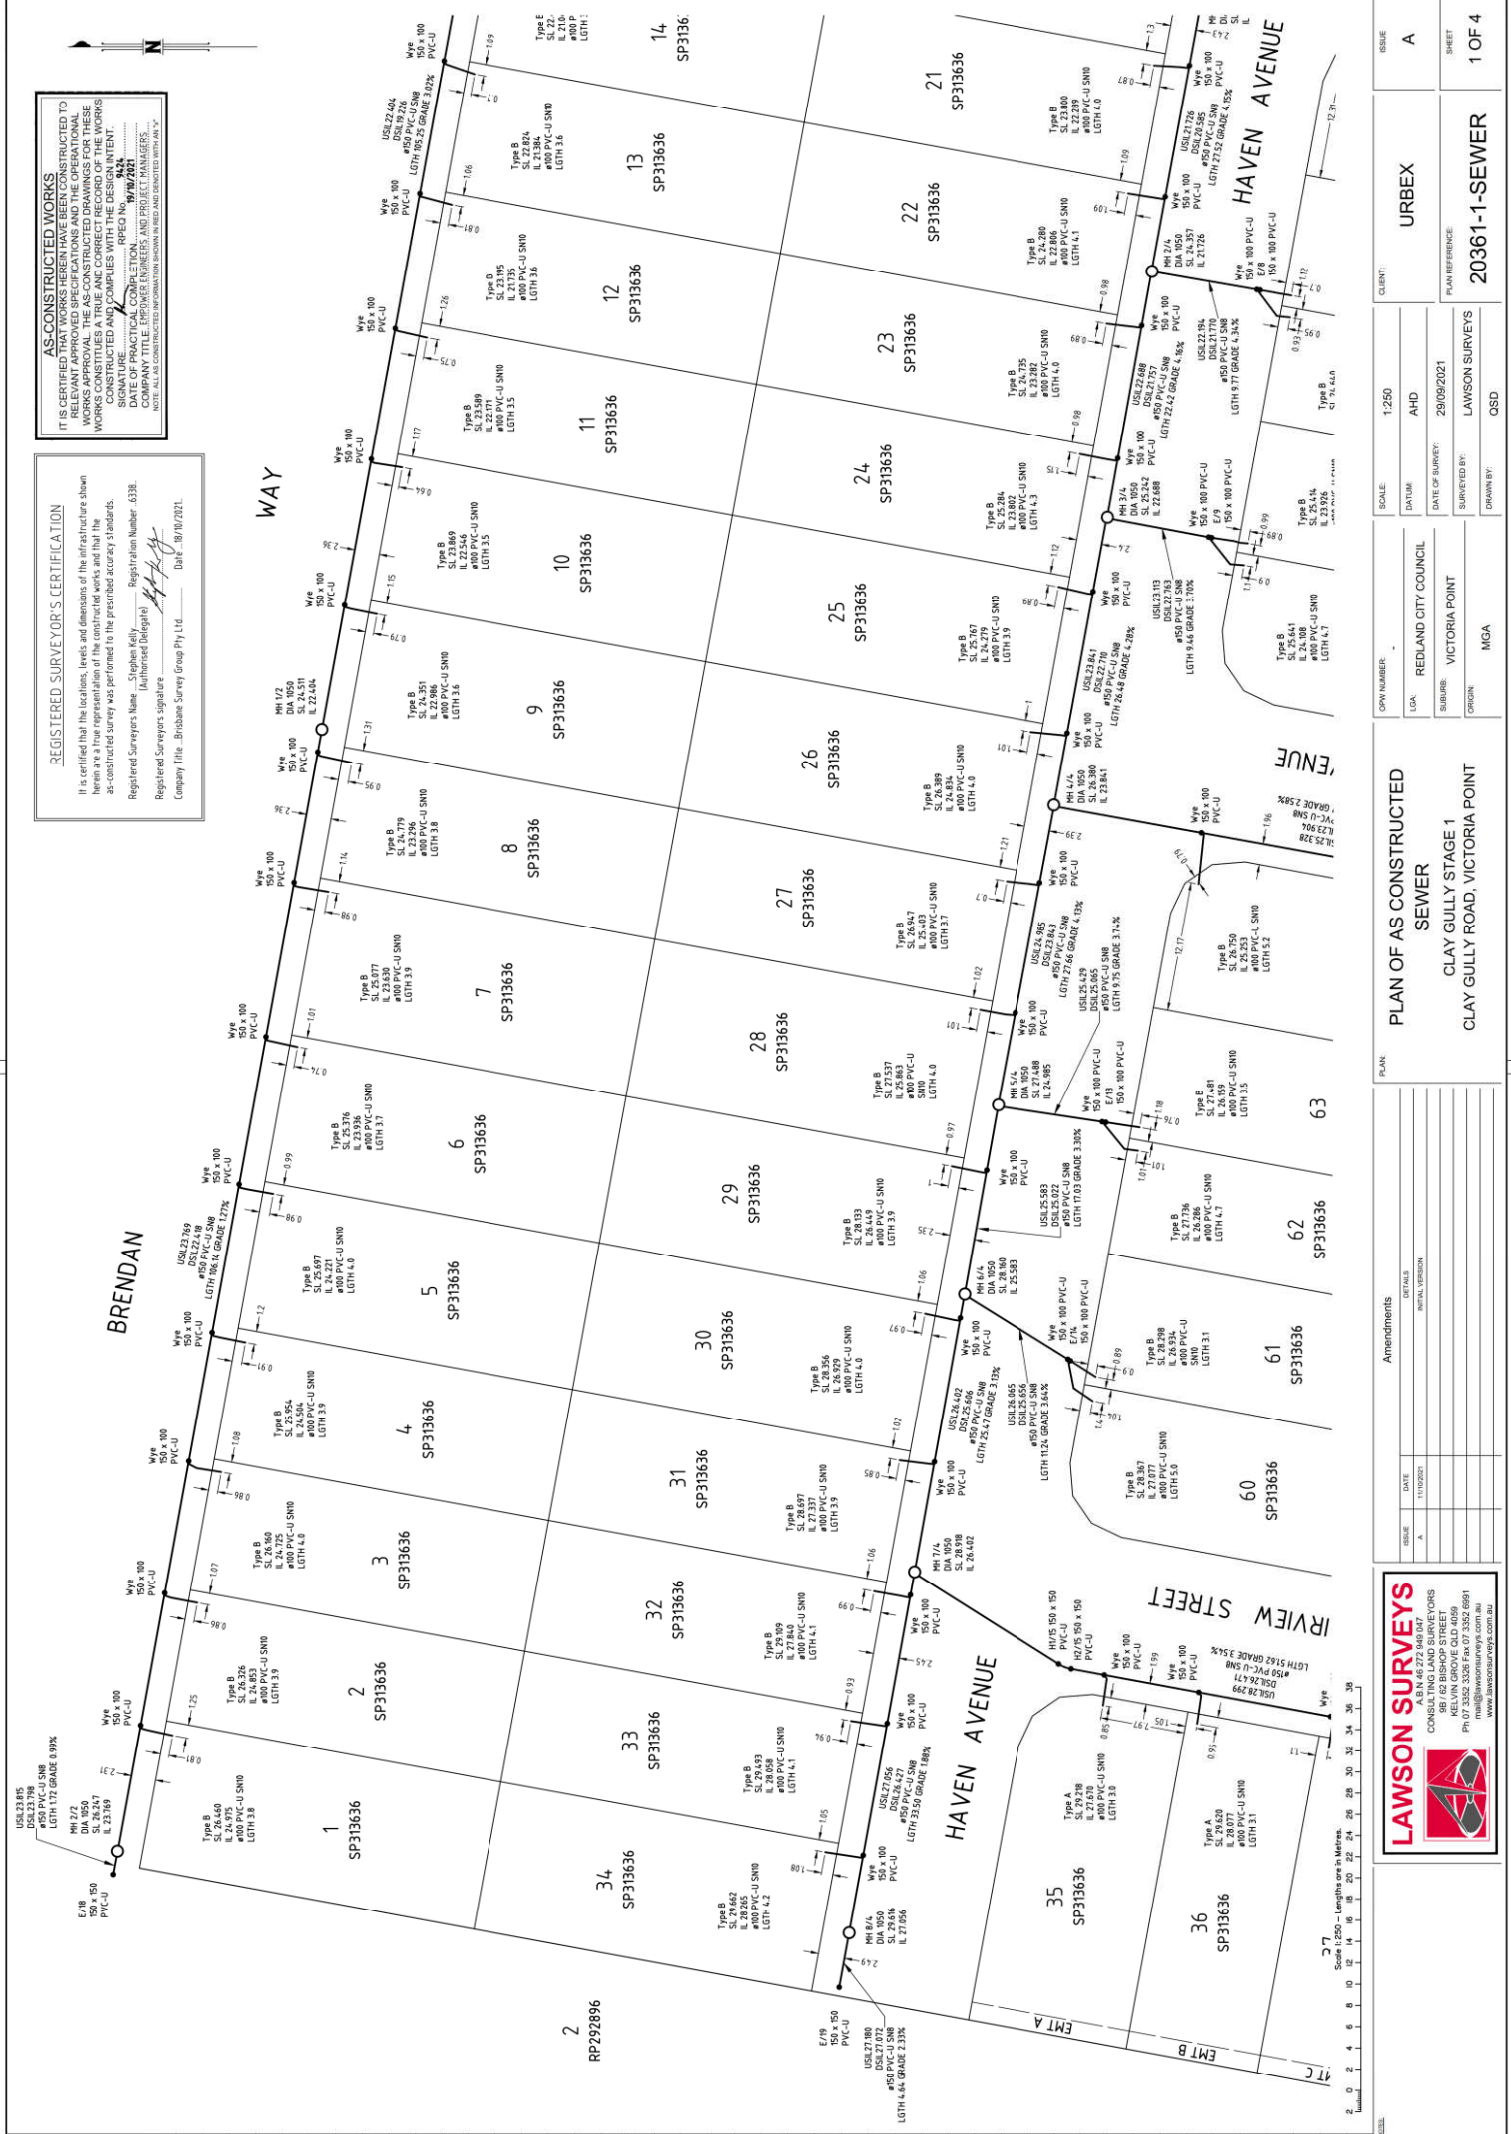

ISSUE	A
CLIENT	URBEX
SCALE	1:250
DATE	AHD
DATE OF SURVEY	29/09/2021
SURVEYED BY	LAWSON SURVEYS
DRAWN BY	QSD
PLAN REFERENCE	20361-1-SEWER
SHEET	1 OF 4

OPW NUMBER	
LOA	REDLAND CITY COUNCIL
SUBURGE	VICTORIA POINT
ORIGIN	MGA

PLAN OF AS CONSTRUCTED SEWER
 CLAY GULLY STAGE 1
 CLAY GULLY ROAD, VICTORIA POINT

ISSUE	DATE	DETAILS
A	11/10/2021	INITIAL VERSION

LAWSON SURVEYS
 A.B.N. 46 272 940 047
 CONSULTING LAND SURVEYORS
 98/102 BISHOP STREET
 SYDNEY NSW 2050
 Ph 07 3352 3328 Fax 07 3352 6991
 msl@lawson-surveys.com.au
 www.lawson-surveys.com.au

SCALE	1:250 - Lengths are in Metres.
-------	--------------------------------