

REGISTERED SURVEYOR'S CERTIFICATION


It is certified that the locations, levels and dimensions of the infrastructure shown herein are a true representation of the constructed works and that the as-constructed survey was performed to the prescribed accuracy standards.

Registered Surveyors Name: Stephen Kelly, Registration Number: 6338
 (Authorised Delegate)
 Registered Surveyors signature: *[Signature]*
 Company Title: Brisbane Survey Group Pty Ltd. Date: 10/11/2021.

AS-CONSTRUCTED WORKS

IT IS CERTIFIED THAT WORKS HEREIN HAVE BEEN CONSTRUCTED TO RELEVANT APPROVED SPECIFICATIONS AND THE OPERATIONAL WORKS APPROVAL. THE AS-CONSTRUCTED DRAWINGS FOR THESE WORKS CONSTITUTE A TRUE AND CORRECT RECORD OF THE WORKS CONSTRUCTED AND COMPLY WITH THE DESIGN INTENT.

SIGNATURE: *[Signature]* RPEQ No. 9474
 DATE OF PRACTICAL COMPLETION: 11/11/2021
 COMPANY TITLE: ENGINEERS AND PROJECT MANAGERS
 NOTE: ALL AS-CONSTRUCTED INFORMATION SHOWN IN RED AND DOTTED WITH 'A'

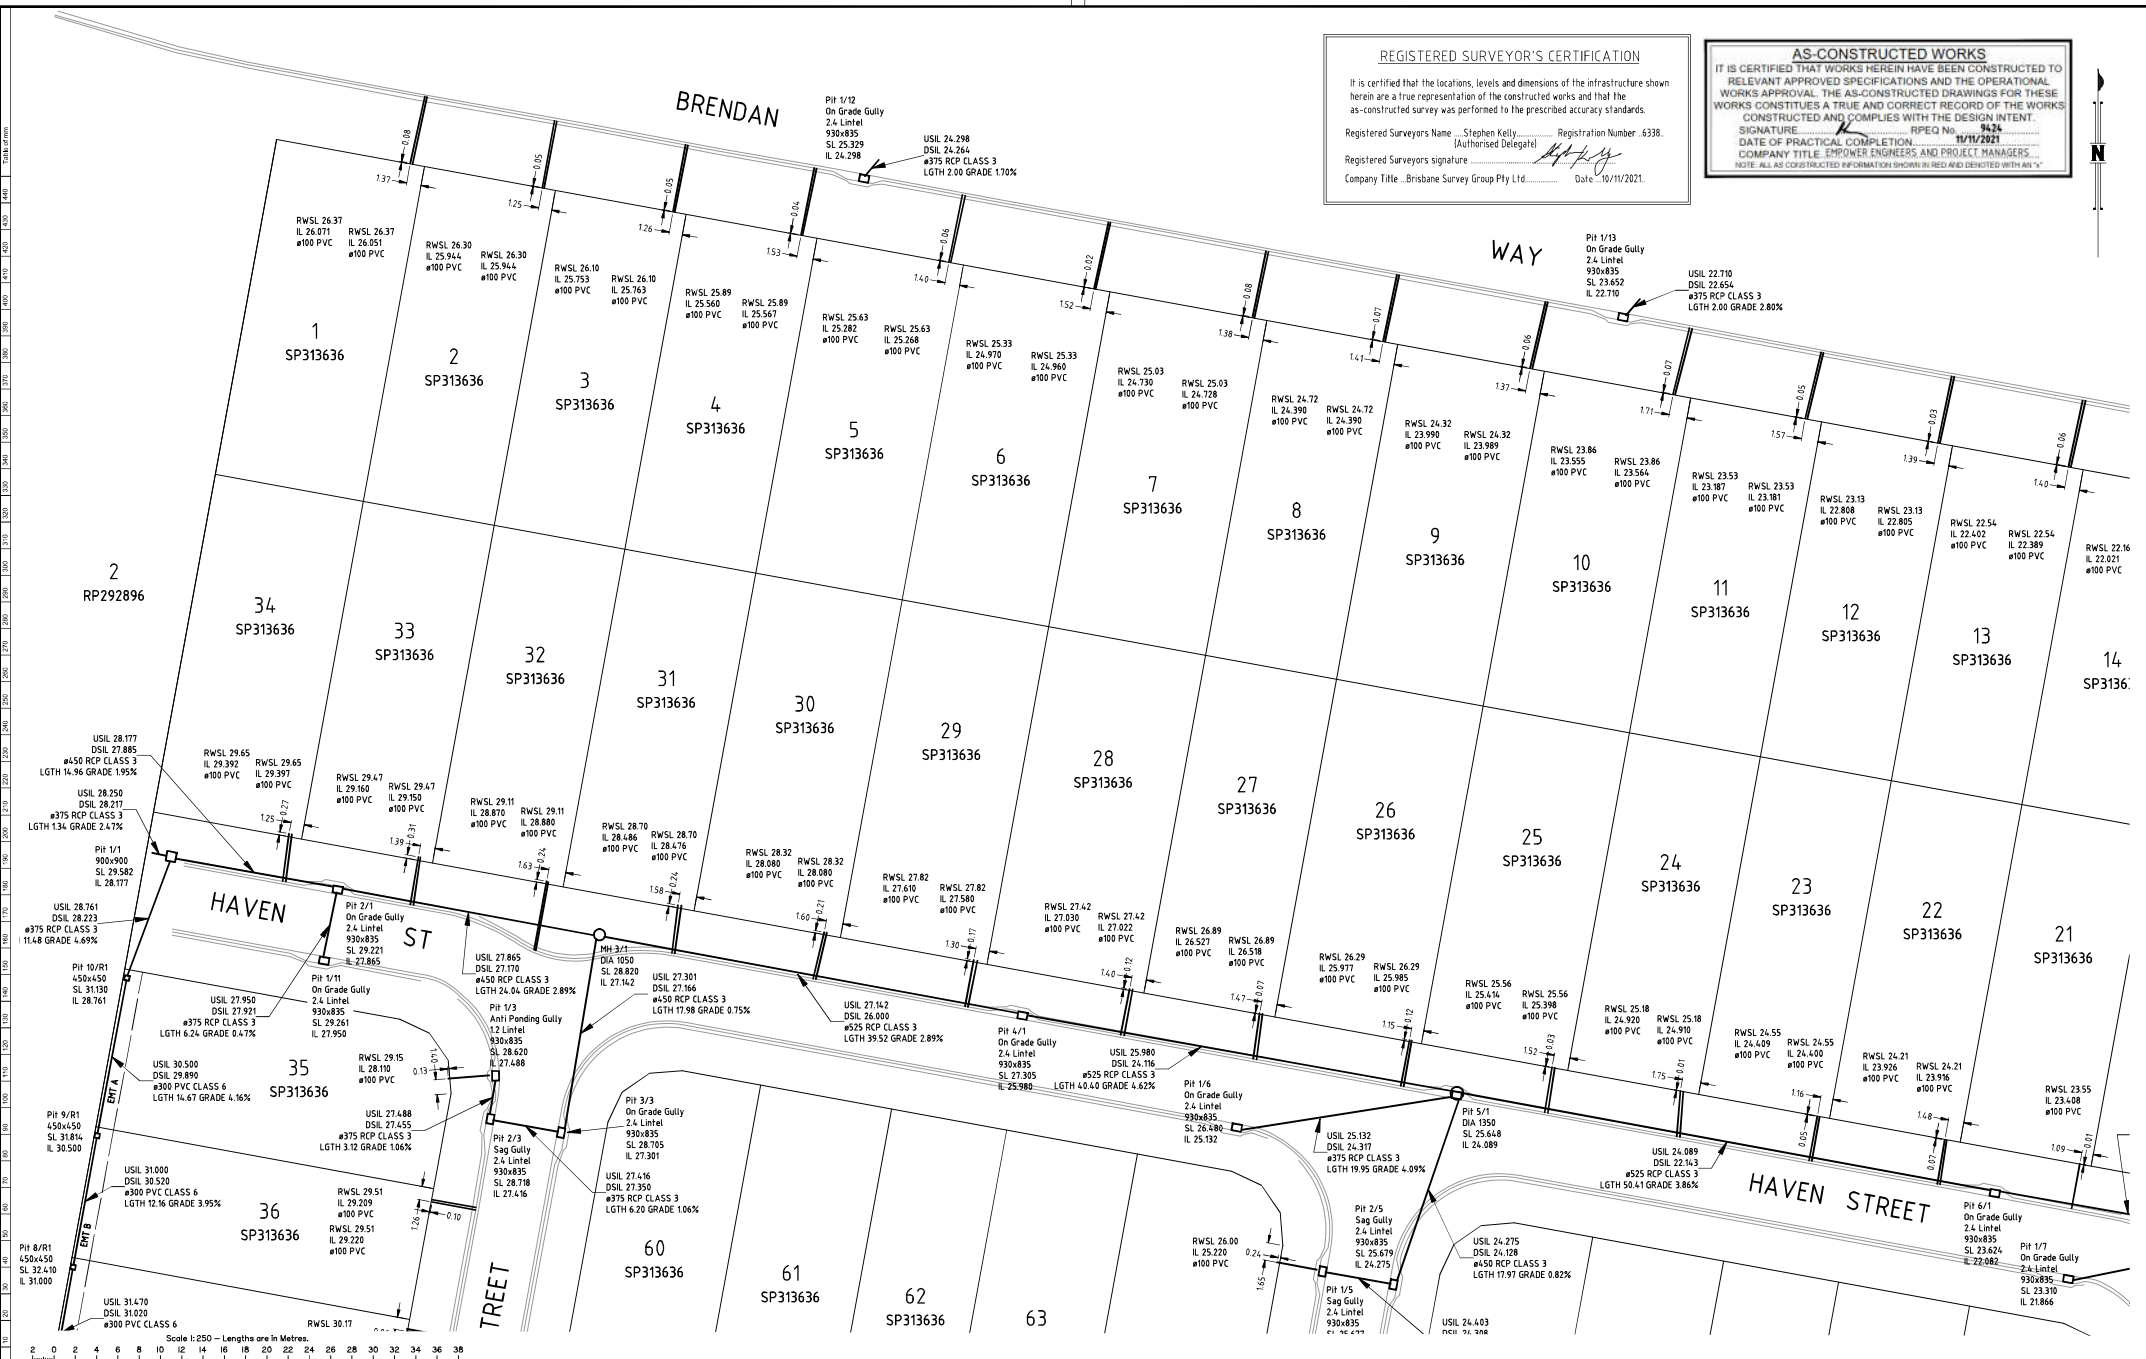

LAWSON SURVEYS
 A.B.N 46 272 949 047
 CONSULTING LAND SURVEYORS
 98 / 62 BISHOP STREET
 MELVING GROVE QLD 4059
 Ph 07 3352 3326 Fax 07 3352 6991
 mail@lawsonsveys.com.au
 www.lawsonsveys.com.au


ISSUE	DATE	DETAILS
A	10/11/2021	FINAL VERSION

PLAN: **PLAN OF AS CONSTRUCTED DRAINAGE**
CLAY GULLY STAGE 1
CLAY GULLY ROAD, VICTORIA POINT

OPW NUMBER: -
 LGA: REDLAND CITY COUNCIL
 SUBURB: VICTORIA POINT
 ORIGIN: MGA

SCALE: 1:250
 DATUM: AHD
 DATE OF SURVEY: 29/09/2021
 SURVEYED BY: LAWSON SURVEYS
 DRAWN BY: QSD

CLIENT: **URBEX**
 PLAN REFERENCE: **20361-1-SW**
 ISSUE: **B**
 SHEET: **1 OF 4**

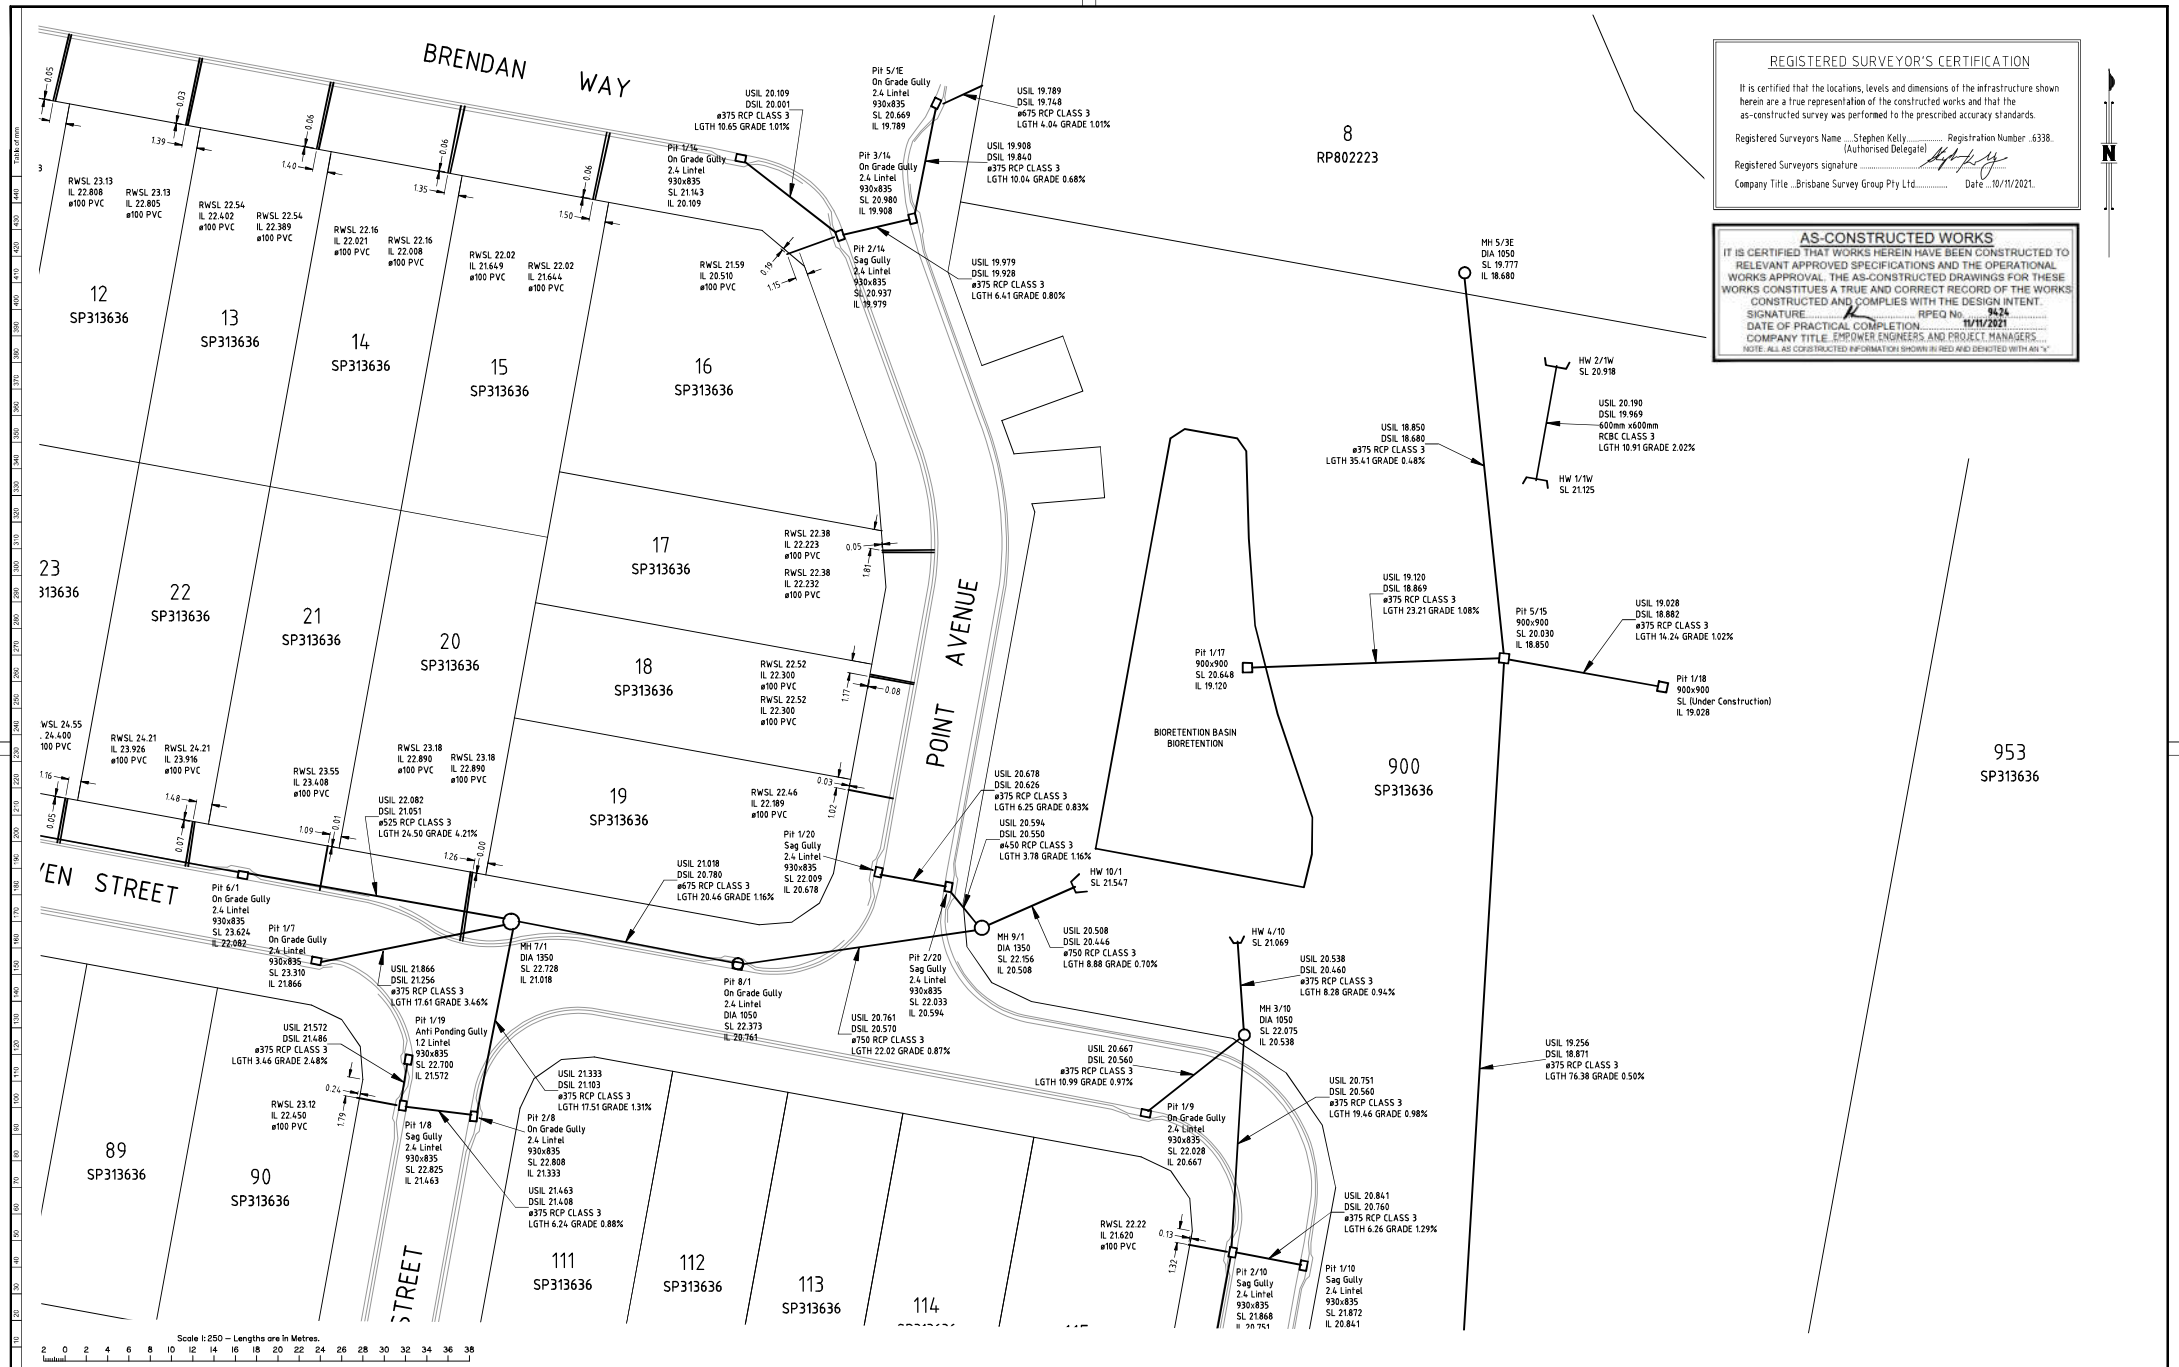

REGISTERED SURVEYOR'S CERTIFICATION

It is certified that the locations, levels and dimensions of the infrastructure shown herein are a true representation of the constructed works and that the as-constructed survey was performed to the prescribed accuracy standards.

Registered Surveyors Name: Stephen Kelly (Authorised Delegate)
 Registration Number: 6338
 Registered Surveyors signature: [Signature]
 Company Title: Brisbane Survey Group Pty Ltd Date: 10/11/2021

AS-CONSTRUCTED WORKS

IT IS CERTIFIED THAT WORKS HEREIN HAVE BEEN CONSTRUCTED TO RELEVANT APPROVED SPECIFICATIONS AND THE OPERATIONAL WORKS APPROVAL. THE AS-CONSTRUCTED DRAWINGS FOR THESE WORKS CONSTITUTE A TRUE AND CORRECT RECORD OF THE WORKS CONSTRUCTED AND COMPLIES WITH THE DESIGN INTENT.

SIGNATURE: [Signature] RPEQ No: 942
 DATE OF PRACTICAL COMPLETION: 10/11/2021
 COMPANY TITLE: EMPOWER ENGINEERS AND PROJECT MANAGERS
 NOTE: ALL AS CONSTRUCTED INFORMATION SHOWN IN RED AND DOTTED WITH AN "A"

Scale 1:250 - Lengths are in Metres.

LAWSON SURVEYS
 A.B.N 46 272 949 047
 CONSULTING LAND SURVEYORS
 98 / 62 BRISBANE STREET
 MELBURN GROVE QLD 4059
 Ph 07 3352 3326 Fax 07 3352 6991
 mail@lawsonsveys.com.au
 www.lawsonsveys.com.au

ISSUE	DATE	DETAILS
A	10/11/2021	INITIAL VERSION

PLAN:
PLAN OF AS CONSTRUCTED DRAINAGE
CLAY GULLY STAGE 1
CLAY GULLY ROAD, VICTORIA POINT

OPW NUMBER: -
 LGA: REDLAND CITY COUNCIL
 SUBURB: VICTORIA POINT
 ORIGIN: MGA


SCALE: 1:250
 DATUM: AHD
 DATE OF SURVEY: 29/09/2021
 SURVEYED BY: LAWSON SURVEYS
 DRAWN BY: QSD

CLIENT:
URBEX

PLAN REFERENCE:
20361-1-SW

ISSUE
B

SHEET
2 OF 4

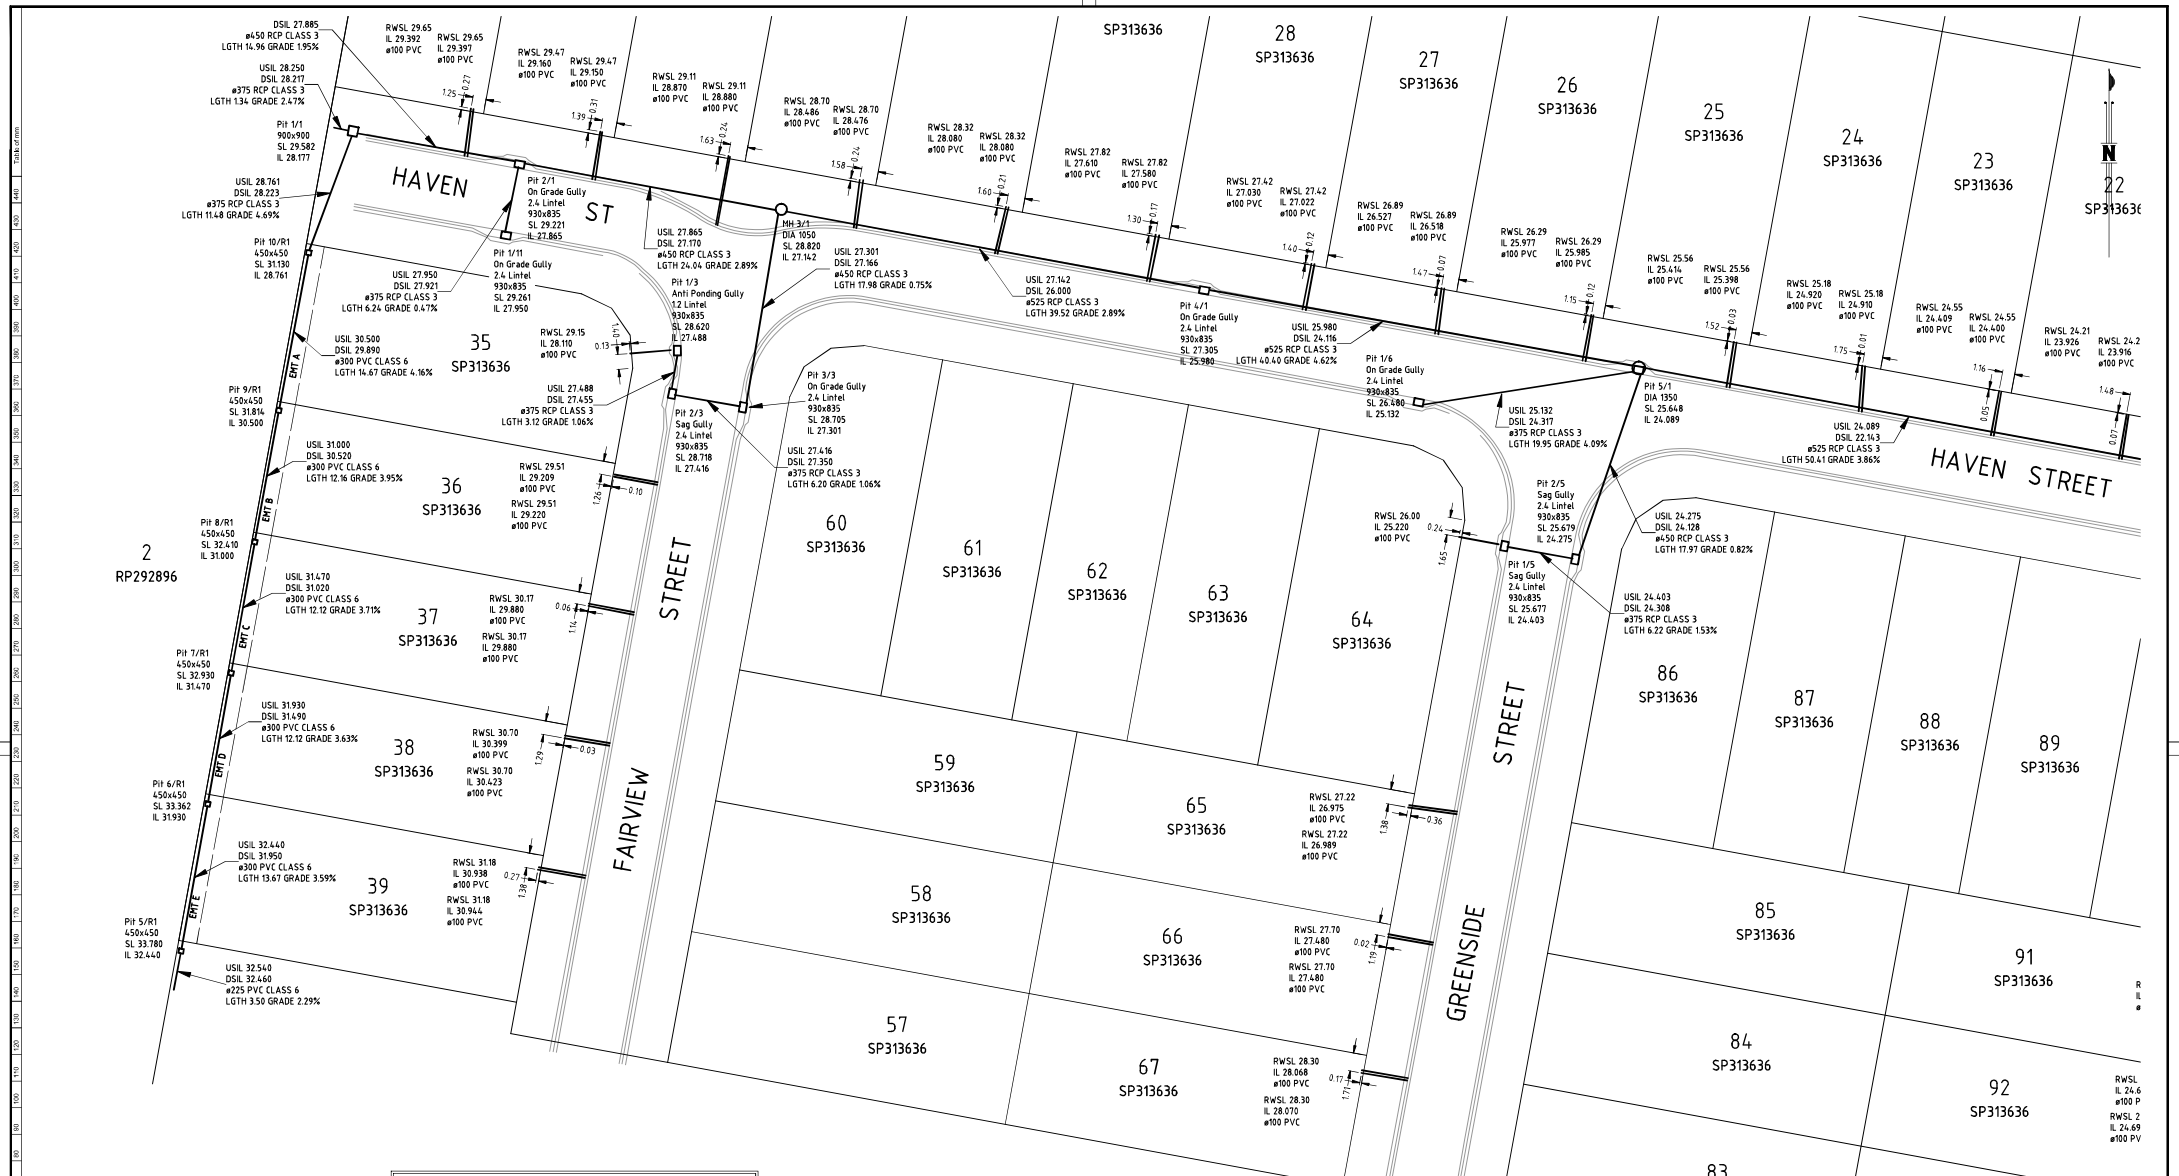

REGISTERED SURVEYOR'S CERTIFICATION

It is certified that the locations, levels and dimensions of the infrastructure shown herein are a true representation of the constructed works and that the as-constructed survey was performed to the prescribed accuracy standards.

Registered Surveyors Name: Stephen Kelly, Registration Number: 6338.
(Authorised Delegate)

Registered Surveyors signature: *[Signature]*

Company Title: Brisbane Survey Group Pty Ltd Date: 10/11/2021.

AS-CONSTRUCTED WORKS

IT IS CERTIFIED THAT WORKS HEREIN HAVE BEEN CONSTRUCTED TO RELEVANT APPROVED SPECIFICATIONS AND THE OPERATIONAL WORKS APPROVAL. THE AS-CONSTRUCTED DRAWINGS FOR THESE WORKS CONSTITUTE A TRUE AND CORRECT RECORD OF THE WORKS CONSTRUCTED AND COMPLIES WITH THE DESIGN INTENT.

SIGNATURE: *[Signature]* RPEQ No: 9424
DATE OF PRACTICAL COMPLETION: 11/11/2021
COMPANY TITLE: EMPLOYER ENGINEERS AND PROJECT MANAGERS
NOTE: ALL AS-CONSTRUCTED INFORMATION SHOWN IN RED AND DENOTED WITH AN "A"

Scale 1:250 - Lengths are in Metres.

0 2 4 6 8 10 12 14 16 18 20 22 24 26 28 30 32 34 36 38

LAWSON SURVEYS
A.B.N 46 272 949 047
CONSULTING LAND SURVEYORS
98 / 62 BISHOP STREET
KELVIN GROVE QLD 4059
Ph 07 3352 3326 Fax 07 3352 6991
mail@lawsonsveys.com.au
www.lawsonsveys.com.au

Amendments		PLAN:
ISSUE	DATE	DETAILS
A	10/11/2021	INITIAL VERSION


PLAN OF AS CONSTRUCTED DRAINAGE
CLAY GULLY STAGE 1
CLAY GULLY ROAD, VICTORIA POINT

OPW NUMBER: -
LGA: REDLAND CITY COUNCIL
SUBURB: VICTORIA POINT
ORIGIN: MGA

SCALE: 1:250
DATUM: AHD
DATE OF SURVEY: 29/09/2021
SURVEYED BY: LAWSON SURVEYS
DRAWN BY: QSD

CLIENT: URBEX
PLAN REFERENCE: 20361-1-SW

ISSUE: B
SHEET: 3 OF 4

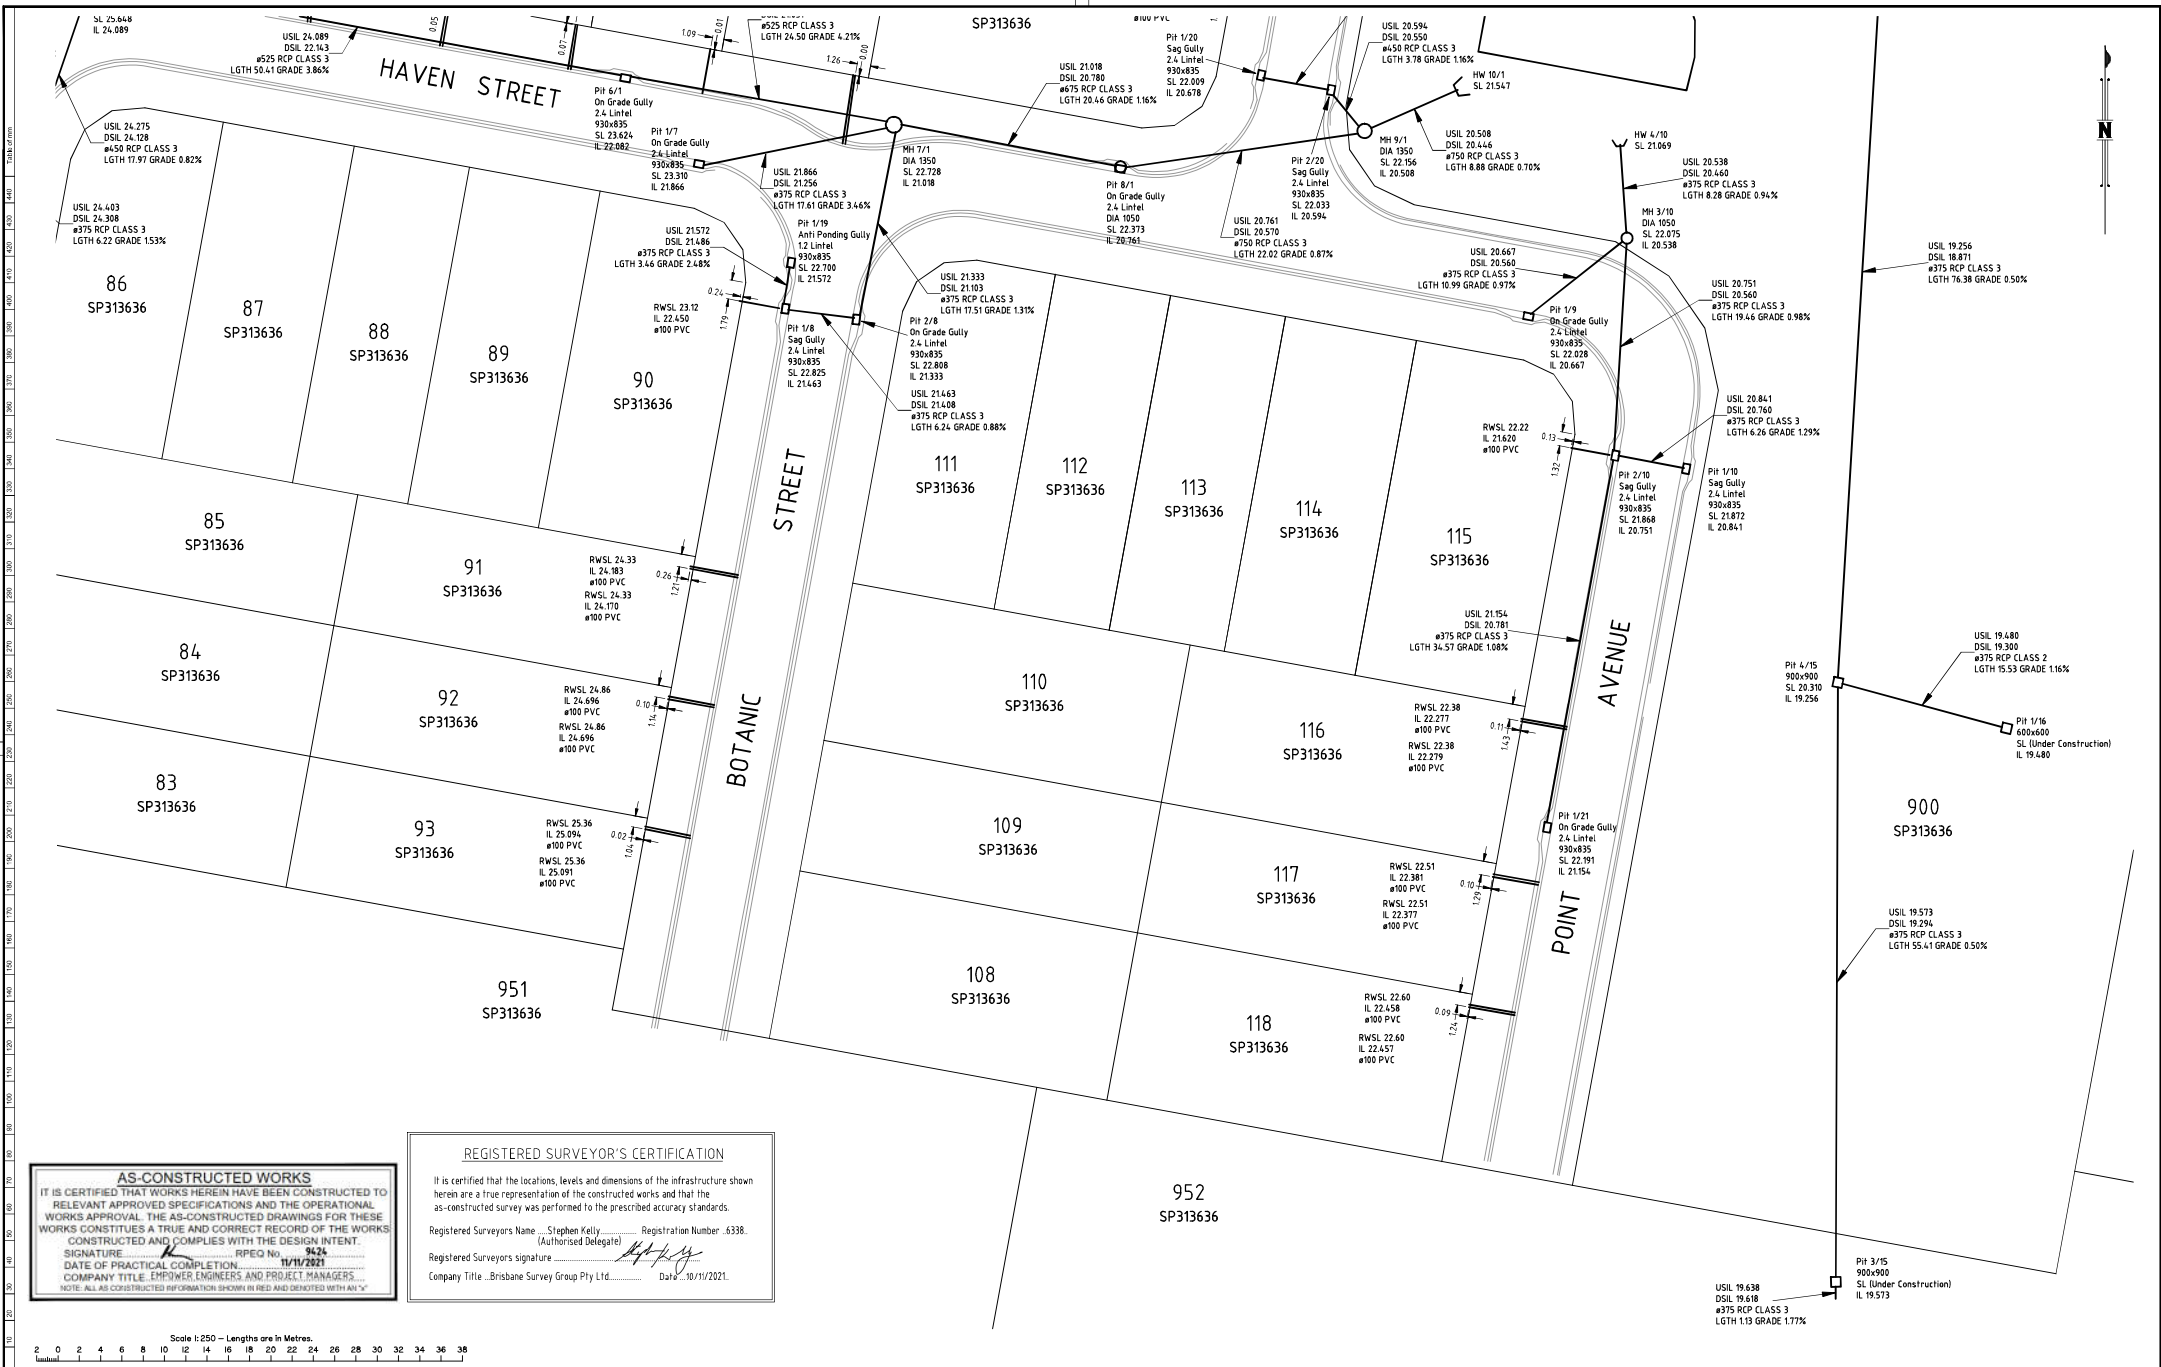

REGISTERED SURVEYOR'S CERTIFICATION

It is certified that the locations, levels and dimensions of the infrastructure shown herein are a true representation of the constructed works and that the as-constructed survey was performed to the prescribed accuracy standards.

Registered Surveyor's Name: Stephen Kelly Registration Number: 6338. (Authorised Delegate)

Registered Surveyor's signature: *[Signature]*

Company Title: Brisbane Survey Group Pty Ltd. Date: 10/11/2021.

AS-CONSTRUCTED WORKS


IT IS CERTIFIED THAT WORKS HEREIN HAVE BEEN CONSTRUCTED TO RELEVANT APPROVED SPECIFICATIONS AND THE OPERATIONAL WORKS APPROVAL. THE AS-CONSTRUCTED DRAWINGS FOR THESE WORKS CONSTITUTE A TRUE AND CORRECT RECORD OF THE WORKS CONSTRUCTED AND COMPLIES WITH THE DESIGN INTENT.

SIGNATURE: *[Signature]* RPEQ No: 9424

DATE OF PRACTICAL COMPLETION: 11/11/2021

COMPANY TITLE: EMPLOYEES AND PROJECT MANAGERS

NOTE: ALL AS-CONSTRUCTED INFORMATION SHOWN IN RED AND DENOTED WITH AN "A"

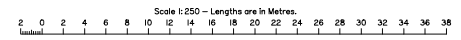

LAWSON SURVEYS

A.B.N 46 272 949 047
 CONSULTING LAND SURVEYORS
 98 / 62 BISHOP STREET
 MELBURN GROVE QLD 4059
 Ph 07 3352 3326 Fax 07 3352 6991
 mail@lawsonsveys.com.au
 www.lawsonsveys.com.au

ISSUE	DATE	DETAILS
A	10/11/2021	INITIAL VERSION

PLAN: **PLAN OF AS CONSTRUCTED DRAINAGE**
CLAY GULLY STAGE 1
CLAY GULLY ROAD, VICTORIA POINT

OPW NUMBER: -
 LGA: REDLAND CITY COUNCIL
 SUBURB: VICTORIA POINT
 ORIGIN: MGA

SCALE: 1:250
 DATUM: AHD
 DATE OF SURVEY: 29/09/2021
 SURVEYED BY: LAWSON SURVEYS
 DRAWN BY: QSD

CLIENT: **URBEX**
 PLAN REFERENCE: **20361-1-SW**

ISSUE: **B**
 SHEET: **4 OF 4**