

REGISTERED SURVEYOR'S CERTIFICATION

It is certified that the locations, levels and dimensions of the infrastructure shown herein are a true representation of the constructed works and that the as-constructed survey was performed to the prescribed accuracy standards.

Registered Surveyors Name: Stephen Kelly (Authorised Delegate) Registration Number: 6338.
 Registered Surveyors signature: [Signature] Date: 28/03/2022.
 Company Title: Brisbane Survey Group Pty Ltd.

AS-CONSTRUCTED WORKS

IT IS CERTIFIED THAT WORKS HEREIN HAVE BEEN CONSTRUCTED TO RELEVANT APPROVED SPECIFICATIONS AND THE OPERATIONAL WORKS APPROVAL. THE AS-CONSTRUCTED DRAWINGS FOR THESE WORKS CONSTITUTE A TRUE AND CORRECT RECORD OF THE WORKS CONSTRUCTED AND COMPLIES WITH THE DESIGN INTENT.

SIGNATURE: [Signature] RPEQ No. 9424
 DATE OF PRACTICAL COMPLETION: 28/03/2022
 COMPANY TITLE: EMPOWER ENGINEERS AND PROJECT MANAGERS
 NOTE: ALL AS CONSTRUCTED INFORMATION SHOWN IN RED AND DENOTED WITH AN "X"

LAWSON SURVEYS
 A.B.N 46 272 949 047
 CONSULTING LAND SURVEYORS
 9B / 62 BISHOP STREET
 KELVIN GROVE QLD 4059
 Ph 07 3352 3326 Fax 07 3352 6991
 mail@lawsonsurveys.com.au
 www.lawsonsurveys.com.au


Amendments	
ISSUE	DETAILS
A	INITIAL VERSION
B	FINAL SURFACE LEVELS UPDATED

PLAN:
PLAN OF AS CONSTRUCTED SEWER
 CLAY GULLY STAGE 2
 CLAY GULLY ROAD, VICTORIA POINT

OPW NUMBER:	OPW21/0089
SCALE:	1:250
DATUM:	AHD
DATE OF SURVEY:	17/03/2022
SURVEYED BY:	LAWSON SURVEYS
DRAWN BY:	QSD

CLIENT:	URBEX
ISSUE:	B
PLAN REFERENCE:	20361-2-SEWER
SHEET:	1 OF 2

OPW NUMBER:	OPW21/0089
SCALE:	1:250
DATUM:	AHD
DATE OF SURVEY:	17/03/2022
SURVEYED BY:	LAWSON SURVEYS
DRAWN BY:	QSD

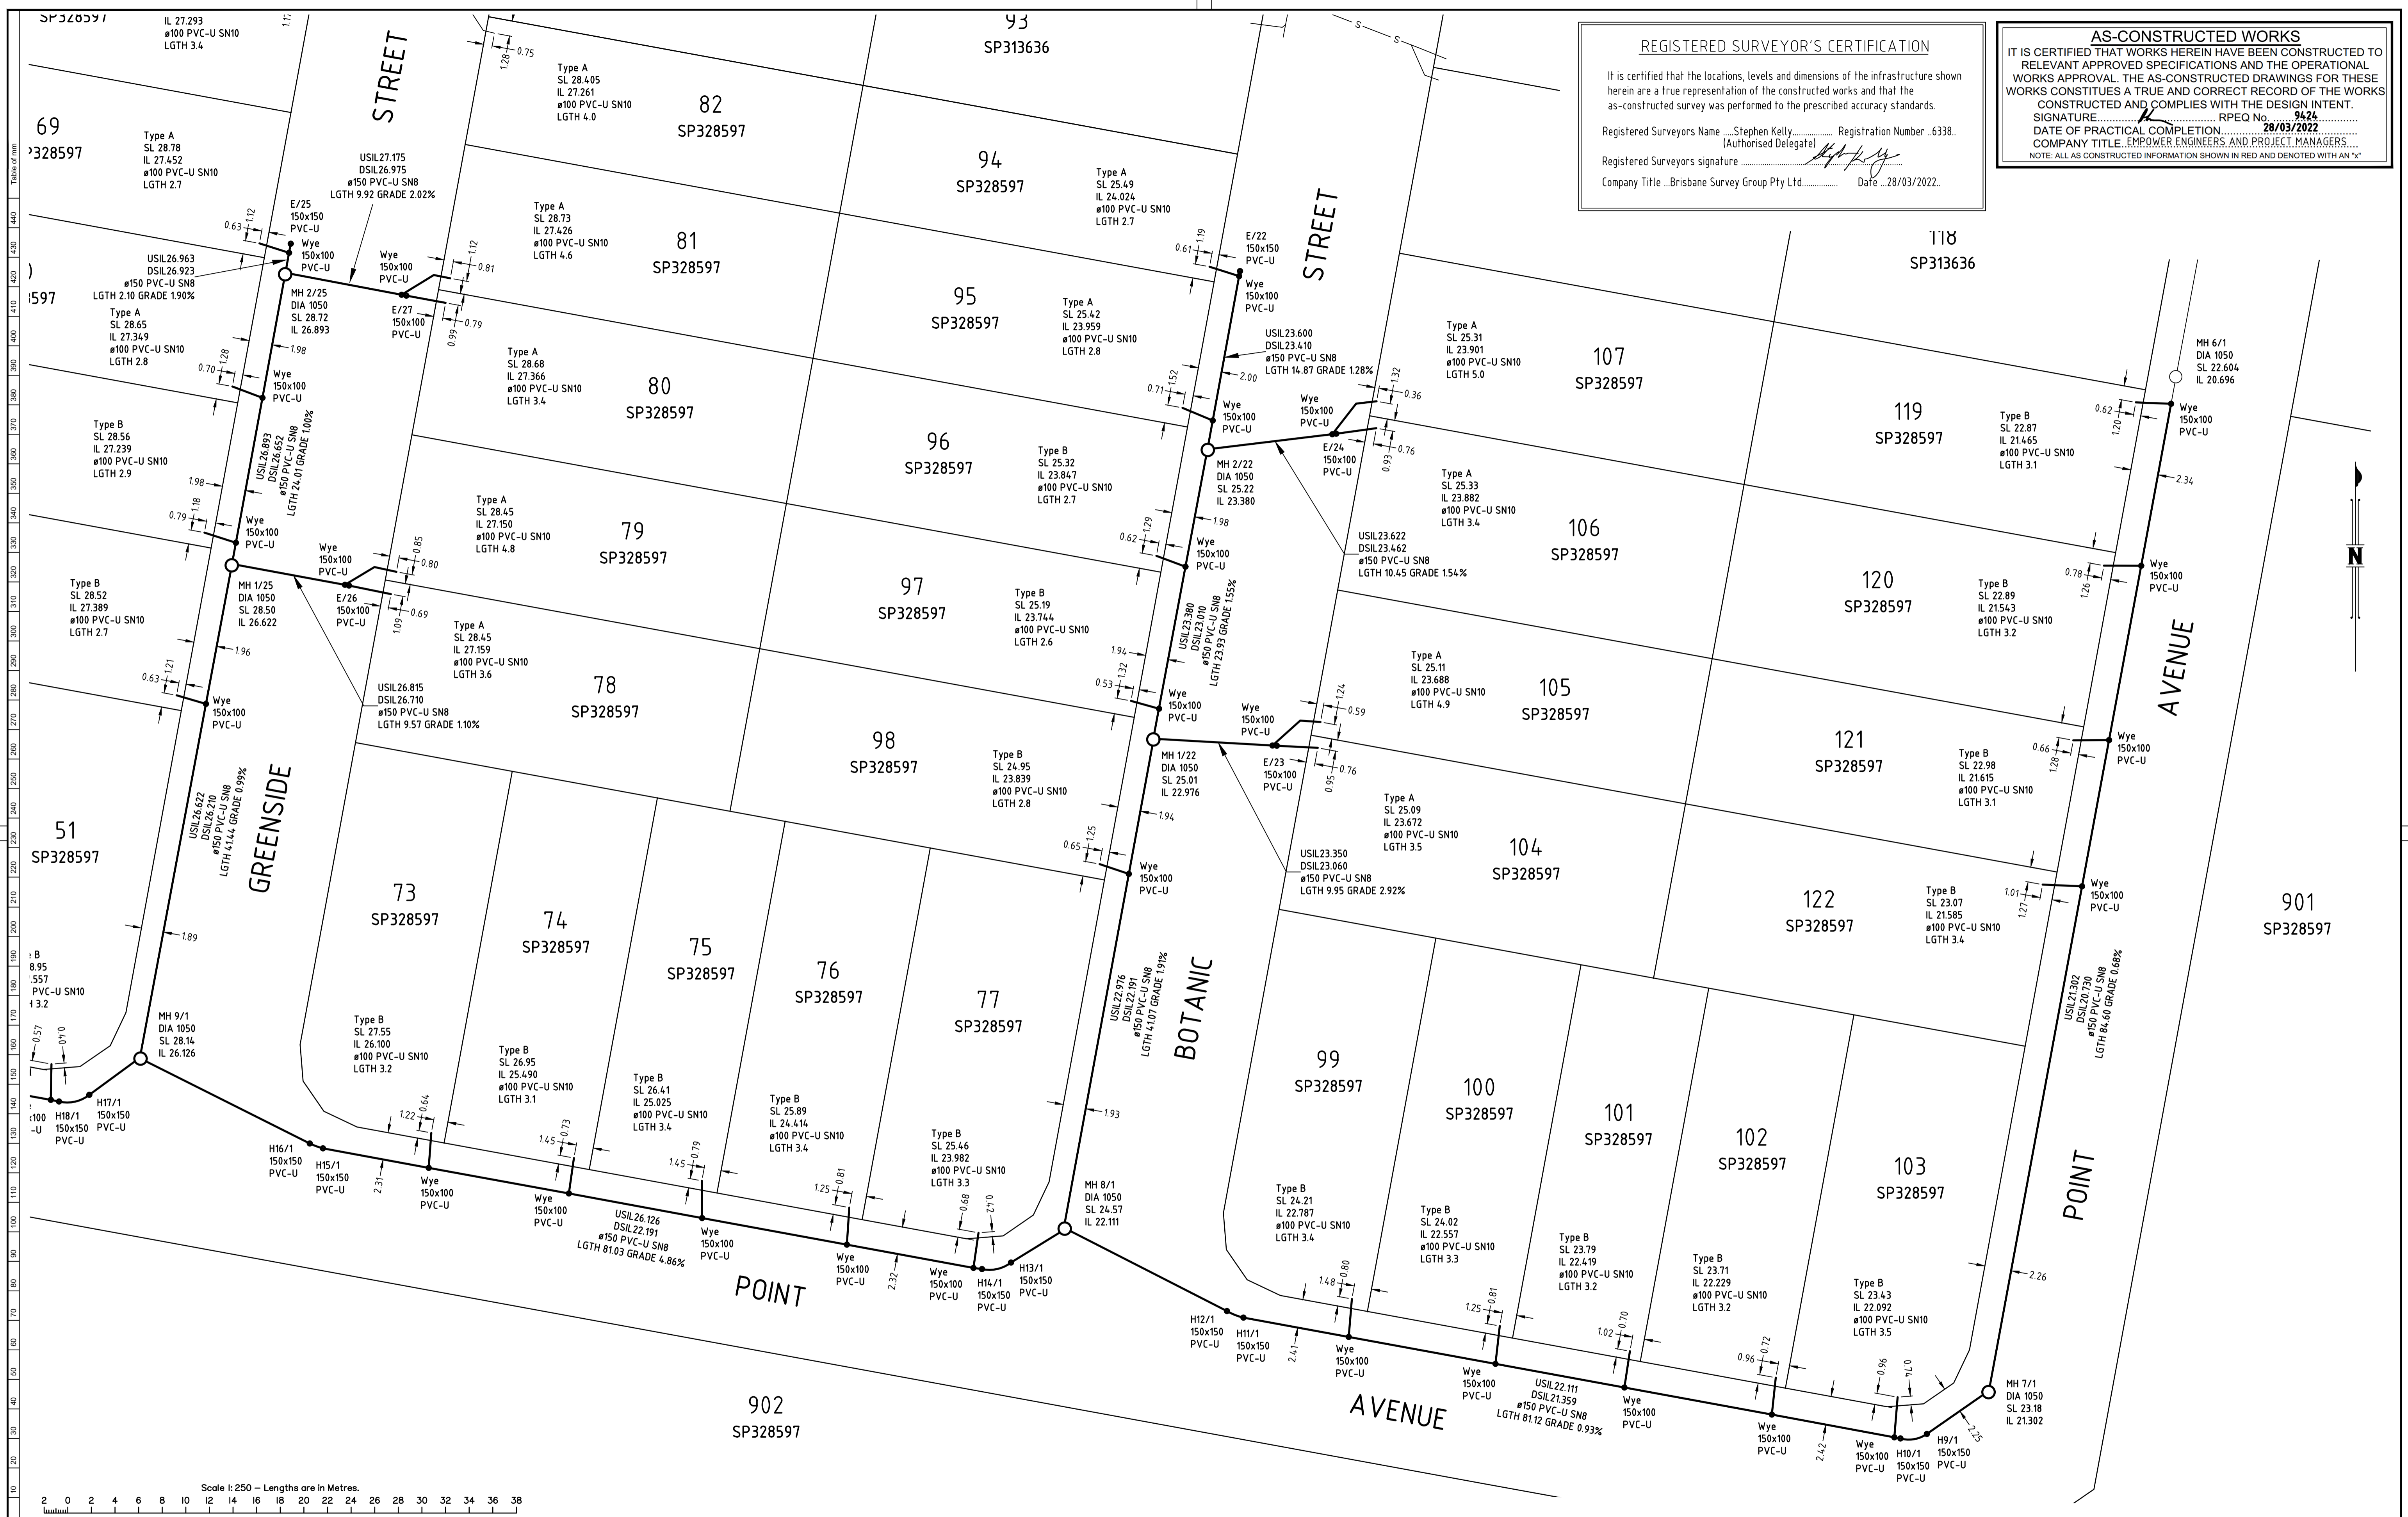

REGISTERED SURVEYOR'S CERTIFICATION

It is certified that the locations, levels and dimensions of the infrastructure shown herein are a true representation of the constructed works and that the as-constructed survey was performed to the prescribed accuracy standards.

Registered Surveyors Name: Stephen Kelly (Authorised Delegate) Registration Number: 6338.
 Registered Surveyors signature: [Signature] Date: 28/03/2022.
 Company Title: Brisbane Survey Group Pty Ltd.

AS-CONSTRUCTED WORKS

IT IS CERTIFIED THAT WORKS HEREIN HAVE BEEN CONSTRUCTED TO RELEVANT APPROVED SPECIFICATIONS AND THE OPERATIONAL WORKS APPROVAL. THE AS-CONSTRUCTED DRAWINGS FOR THESE WORKS CONSTITUTE A TRUE AND CORRECT RECORD OF THE WORKS CONSTRUCTED AND COMPLIES WITH THE DESIGN INTENT.

SIGNATURE: [Signature] RPEQ No. 9424
 DATE OF PRACTICAL COMPLETION: 28/03/2022
 COMPANY TITLE: EMPOWER ENGINEERS AND PROJECT MANAGERS
 NOTE: ALL AS CONSTRUCTED INFORMATION SHOWN IN RED AND DENOTED WITH AN "X"

Scale 1:250 - Lengths are in Metres.

LAWSON SURVEYS
 A.B.N 46 272 949 047
 CONSULTING LAND SURVEYORS
 9B / 62 BISHOP STREET
 KELVIN GROVE QLD 4059
 Ph 07 3352 3326 Fax 07 3352 6991
 mail@lawsonsurveys.com.au
 www.lawsonsurveys.com.au

Amendments		DETAILS
ISSUE	DATE	
A	24/01/2022	INITIAL VERSION
B	28/03/2022	FINAL SURFACE LEVELS UPDATED

PLAN:
PLAN OF AS CONSTRUCTED SEWER
 CLAY GULLY STAGE 2
 CLAY GULLY ROAD, VICTORIA POINT

OPW NUMBER: OPW21/0089
 LGA: REDLAND CITY COUNCIL
 SUBURB: VICTORIA POINT
 ORIGIN: MGA

SCALE: 1:250
 DATUM: AHD
 DATE OF SURVEY: 17/03/2022
 SURVEYED BY: LAWSON SURVEYS
 DRAWN BY: QSD

CLIENT: URBEX
 PLAN REFERENCE: 20361-2-SEWER
 ISSUE: B
 SHEET: 2 OF 2