

Table of mm  
10 20 30 40 50 60 70 80 90 100 110 120 130 140 150 160 170 180 190 200 210 220 230 240 250 260 270 280 290 300 310 320 330 340 350 360 370 380 390 400 410 420 430 440

REGISTERED SURVEYOR'S CERTIFICATION

It is certified that the locations, levels and dimensions of the infrastructure shown herein are a true representation of the constructed works and that the as-constructed survey was performed to the prescribed accuracy standards.

Registered Surveyors Name ...Stephen Kelly..... Registration Number ..6338.. (Authorised Delegate)

Registered Surveyors signature .....

Company Title ..Brisbane Survey Group Pty Ltd..... Date ...07/08/2025..


ENGINEER'S CERTIFICATION

It is certified that the works herein have been constructed to relevant approved specifications and the operational works approval. The as-constructed drawings for these works constitutes a true and correct record of the works constructed and complies with the design intent.

Signature ..... RPEQ No.....

Date of Practical Completion .....

Company Title .....

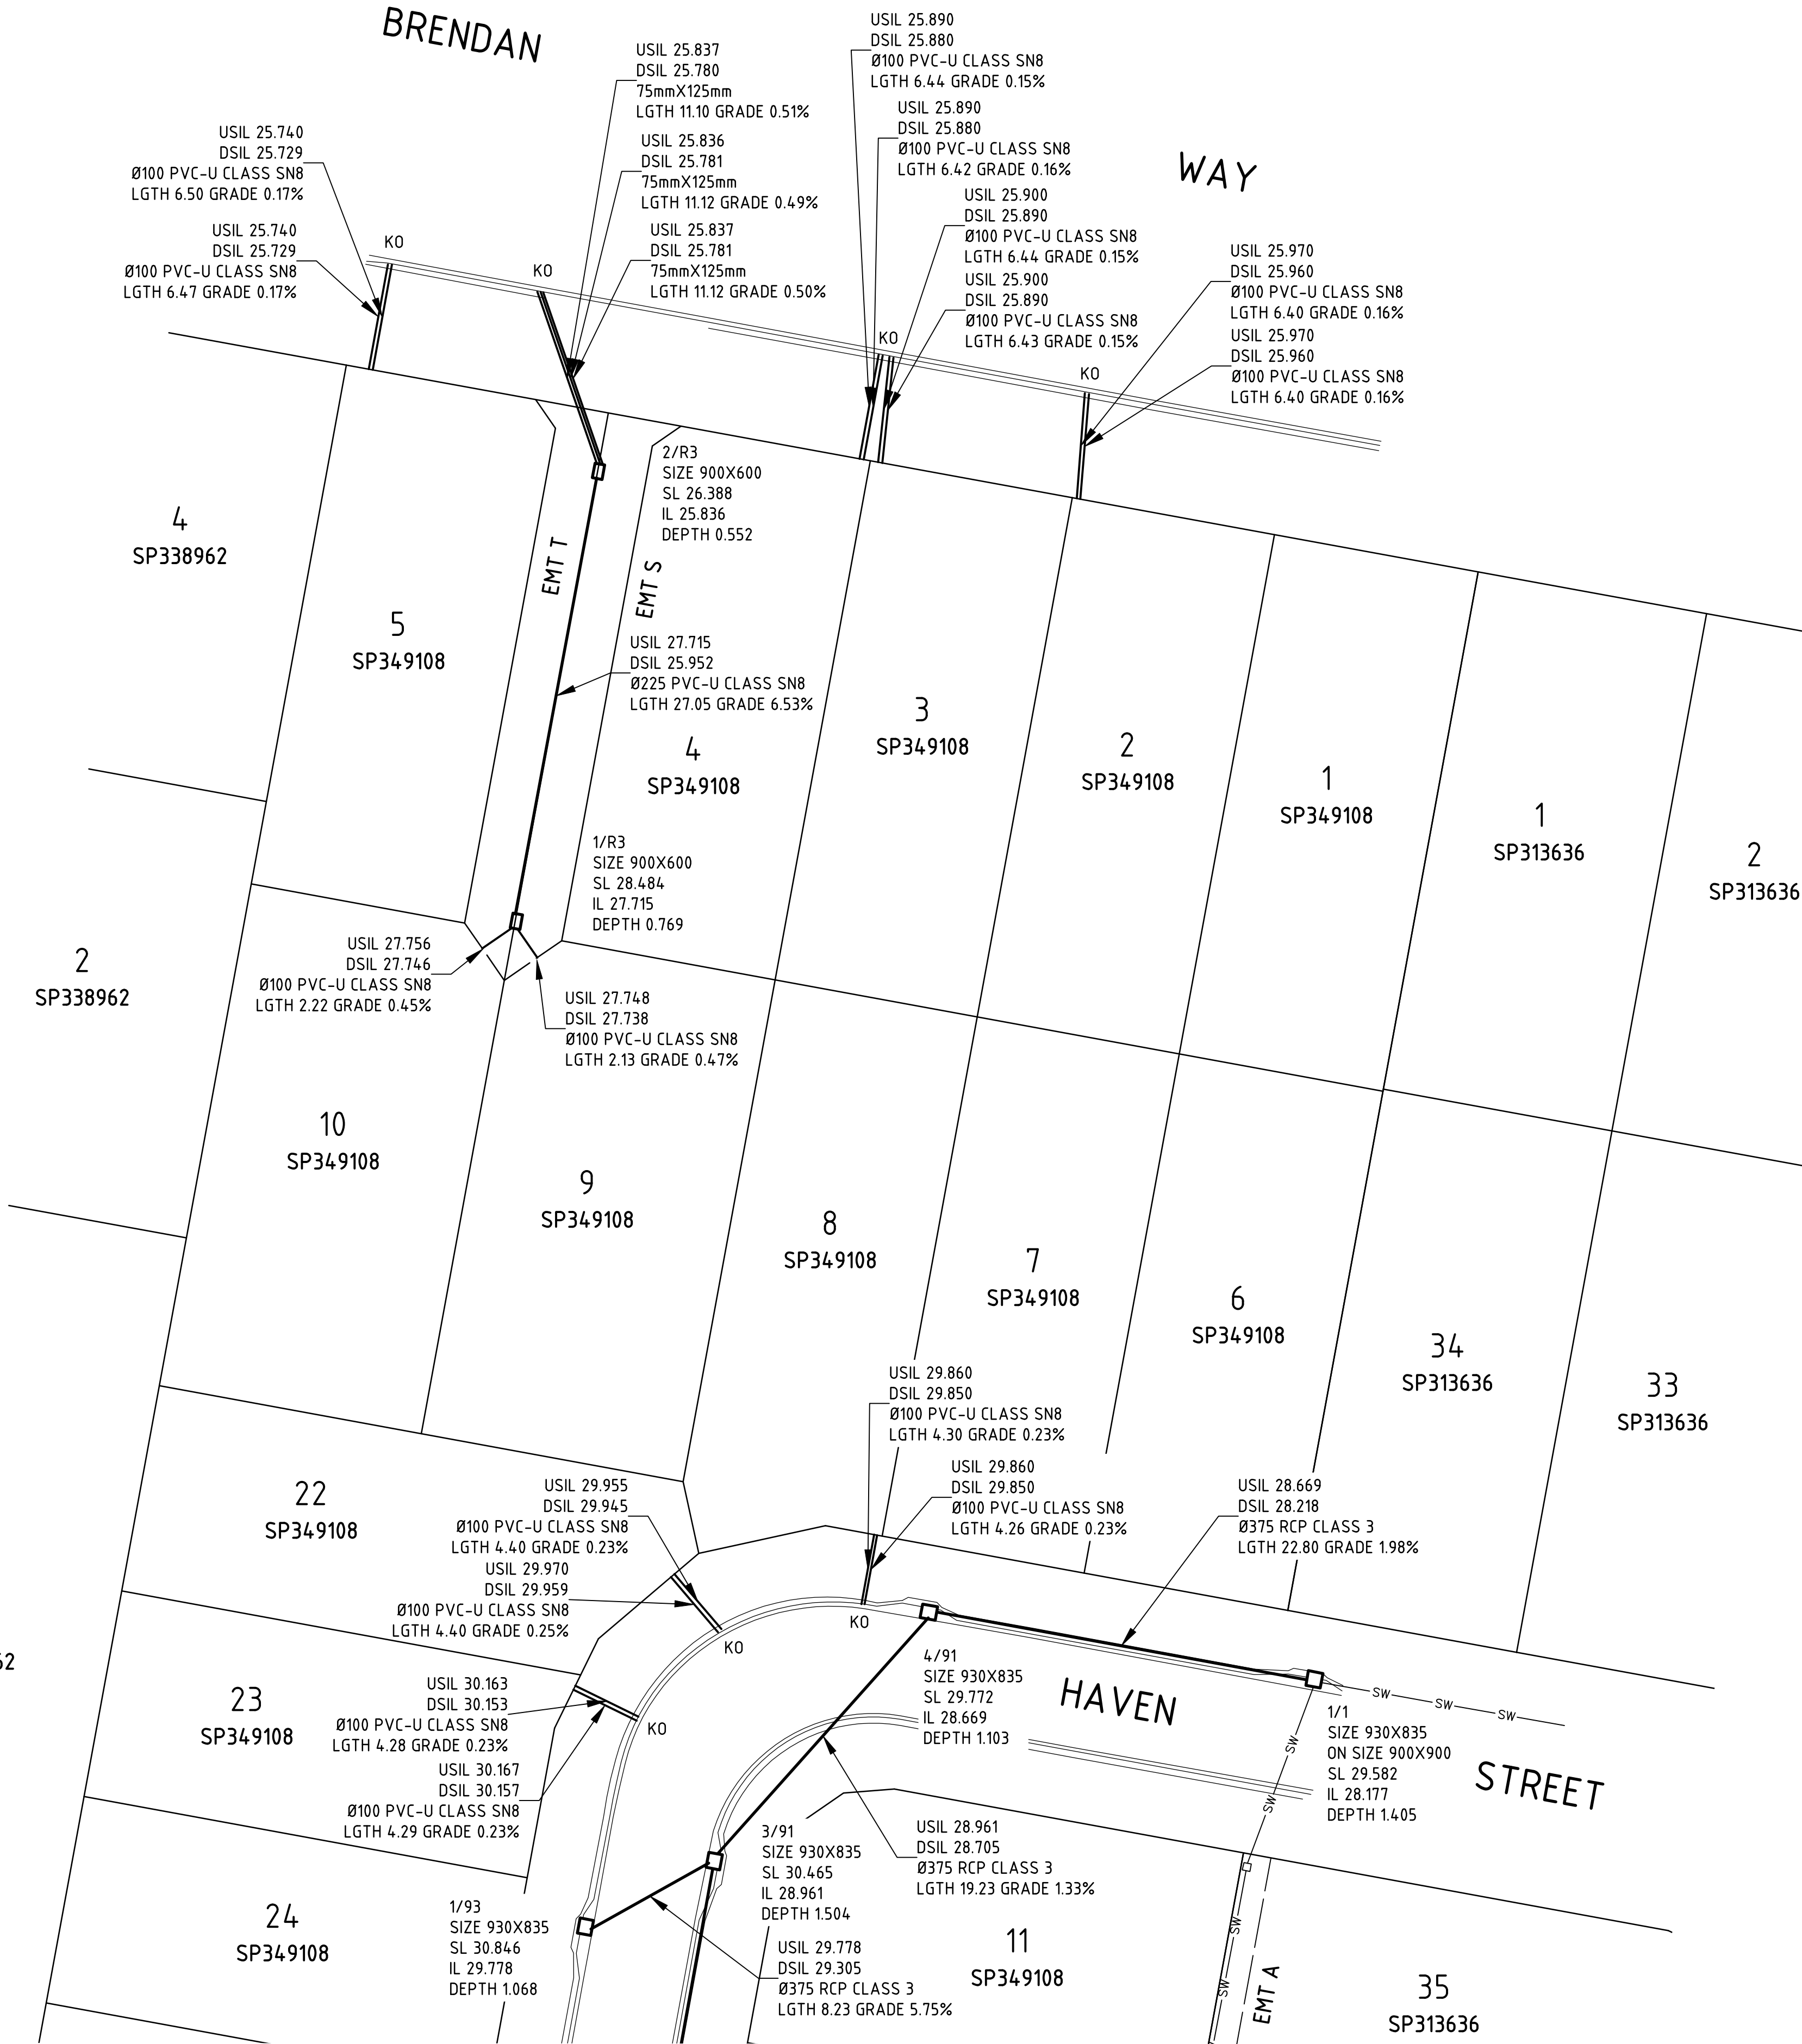

NOTES:

LAWSON SURVEYS



A.B.N 46 272 949 047  
CONSULTING LAND SURVEYORS  
9B / 62 BISHOP STREET  
KELVIN GROVE QLD 4059  
Ph 07 3352 3326 Fax 07 3352 6991  
mail@lawsonsurveys.com.au  
www.lawsonsurveys.com.au

Amendments

| ISSUE | DATE | DETAILS |
|-------|------|---------|
|       |      |         |
|       |      |         |
PLAN:

PLAN OF AS CONSTRUCTED  
DRAINAGE  
CLAY GULLY STAGE 6  
CLAY GULLY ROAD, VICTORIA POINT

OPW NUMBER:

OPW /

LGA:

REDLAND CITY COUNCIL

SUBURB:

VICTORIA POINT

ORIGIN:

MGA

SCALE:

1:250

DATUM:

AHD

DATE OF SURVEY:

22/07/2025


SURVEYED BY:

LAWSON SURVEYS

DRAWN BY:

QSD

Scale 1:250 - Lengths are in Metres.

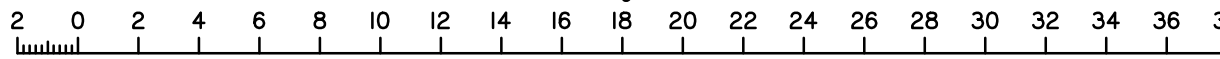

CLIENT:

URBEX

PLAN REFERENCE:

20361-6-SW

ISSUE

INT

SHEET

1 OF 3

Table of mm  
440  
430  
420  
REGISTERED SURVEYOR'S CERTIFICATION

It is certified that the locations, levels and dimensions of the infrastructure shown herein are a true representation of the constructed works and that the as-constructed survey was performed to the prescribed accuracy standards.

Registered Surveyors Name ...Stephen Kelly..... Registration Number ..6338.. (Authorised Delegate)

Registered Surveyors signature .....

Company Title ..Brisbane Survey Group Pty Ltd..... Date ...07/08/2025..


ENGINEER'S CERTIFICATION

It is certified that the works herein have been constructed to relevant approved specifications and the operational works approval. The as-constructed drawings for these works constitutes a true and correct record of the works constructed and complies with the design intent.

Signature ..... RPEQ No.....

Date of Practical Completion .....

Company Title .....

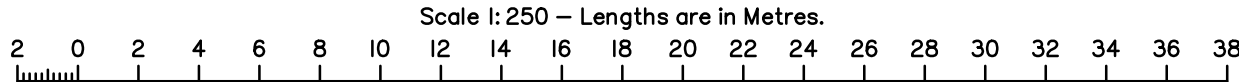

NOTES:

**LAWSON SURVEYS**



A.B.N 46 272 949 047  
CONSULTING LAND SURVEYORS  
9B / 62 BISHOP STREET  
KELVIN GROVE QLD 4059  
Ph 07 3352 3326 Fax 07 3352 6991  
mail@lawsonsurveys.com.au  
www.lawsonsurveys.com.au

Amendments

| ISSUE | DATE | DETAILS |
|-------|------|---------|
|       |      |         |
|       |      |         |
PLAN:

**PLAN OF AS CONSTRUCTED  
DRAINAGE**  
  
CLAY GULLY STAGE 6  
CLAY GULLY ROAD, VICTORIA POINT

OPW NUMBER:

OPW /

LGA:

REDLAND CITY COUNCIL

SUBURB:

VICTORIA POINT

ORIGIN:

MGA

SCALE:

1:250

DATUM:

AHD

DATE OF SURVEY:

22/07/2025

SURVEYED BY:

LAWSON SURVEYS

DRAWN BY:

QSD

CLIENT:

URBEX

PLAN REFERENCE:


20361-6-SW

ISSUE

INT

SHEET

2 OF 3

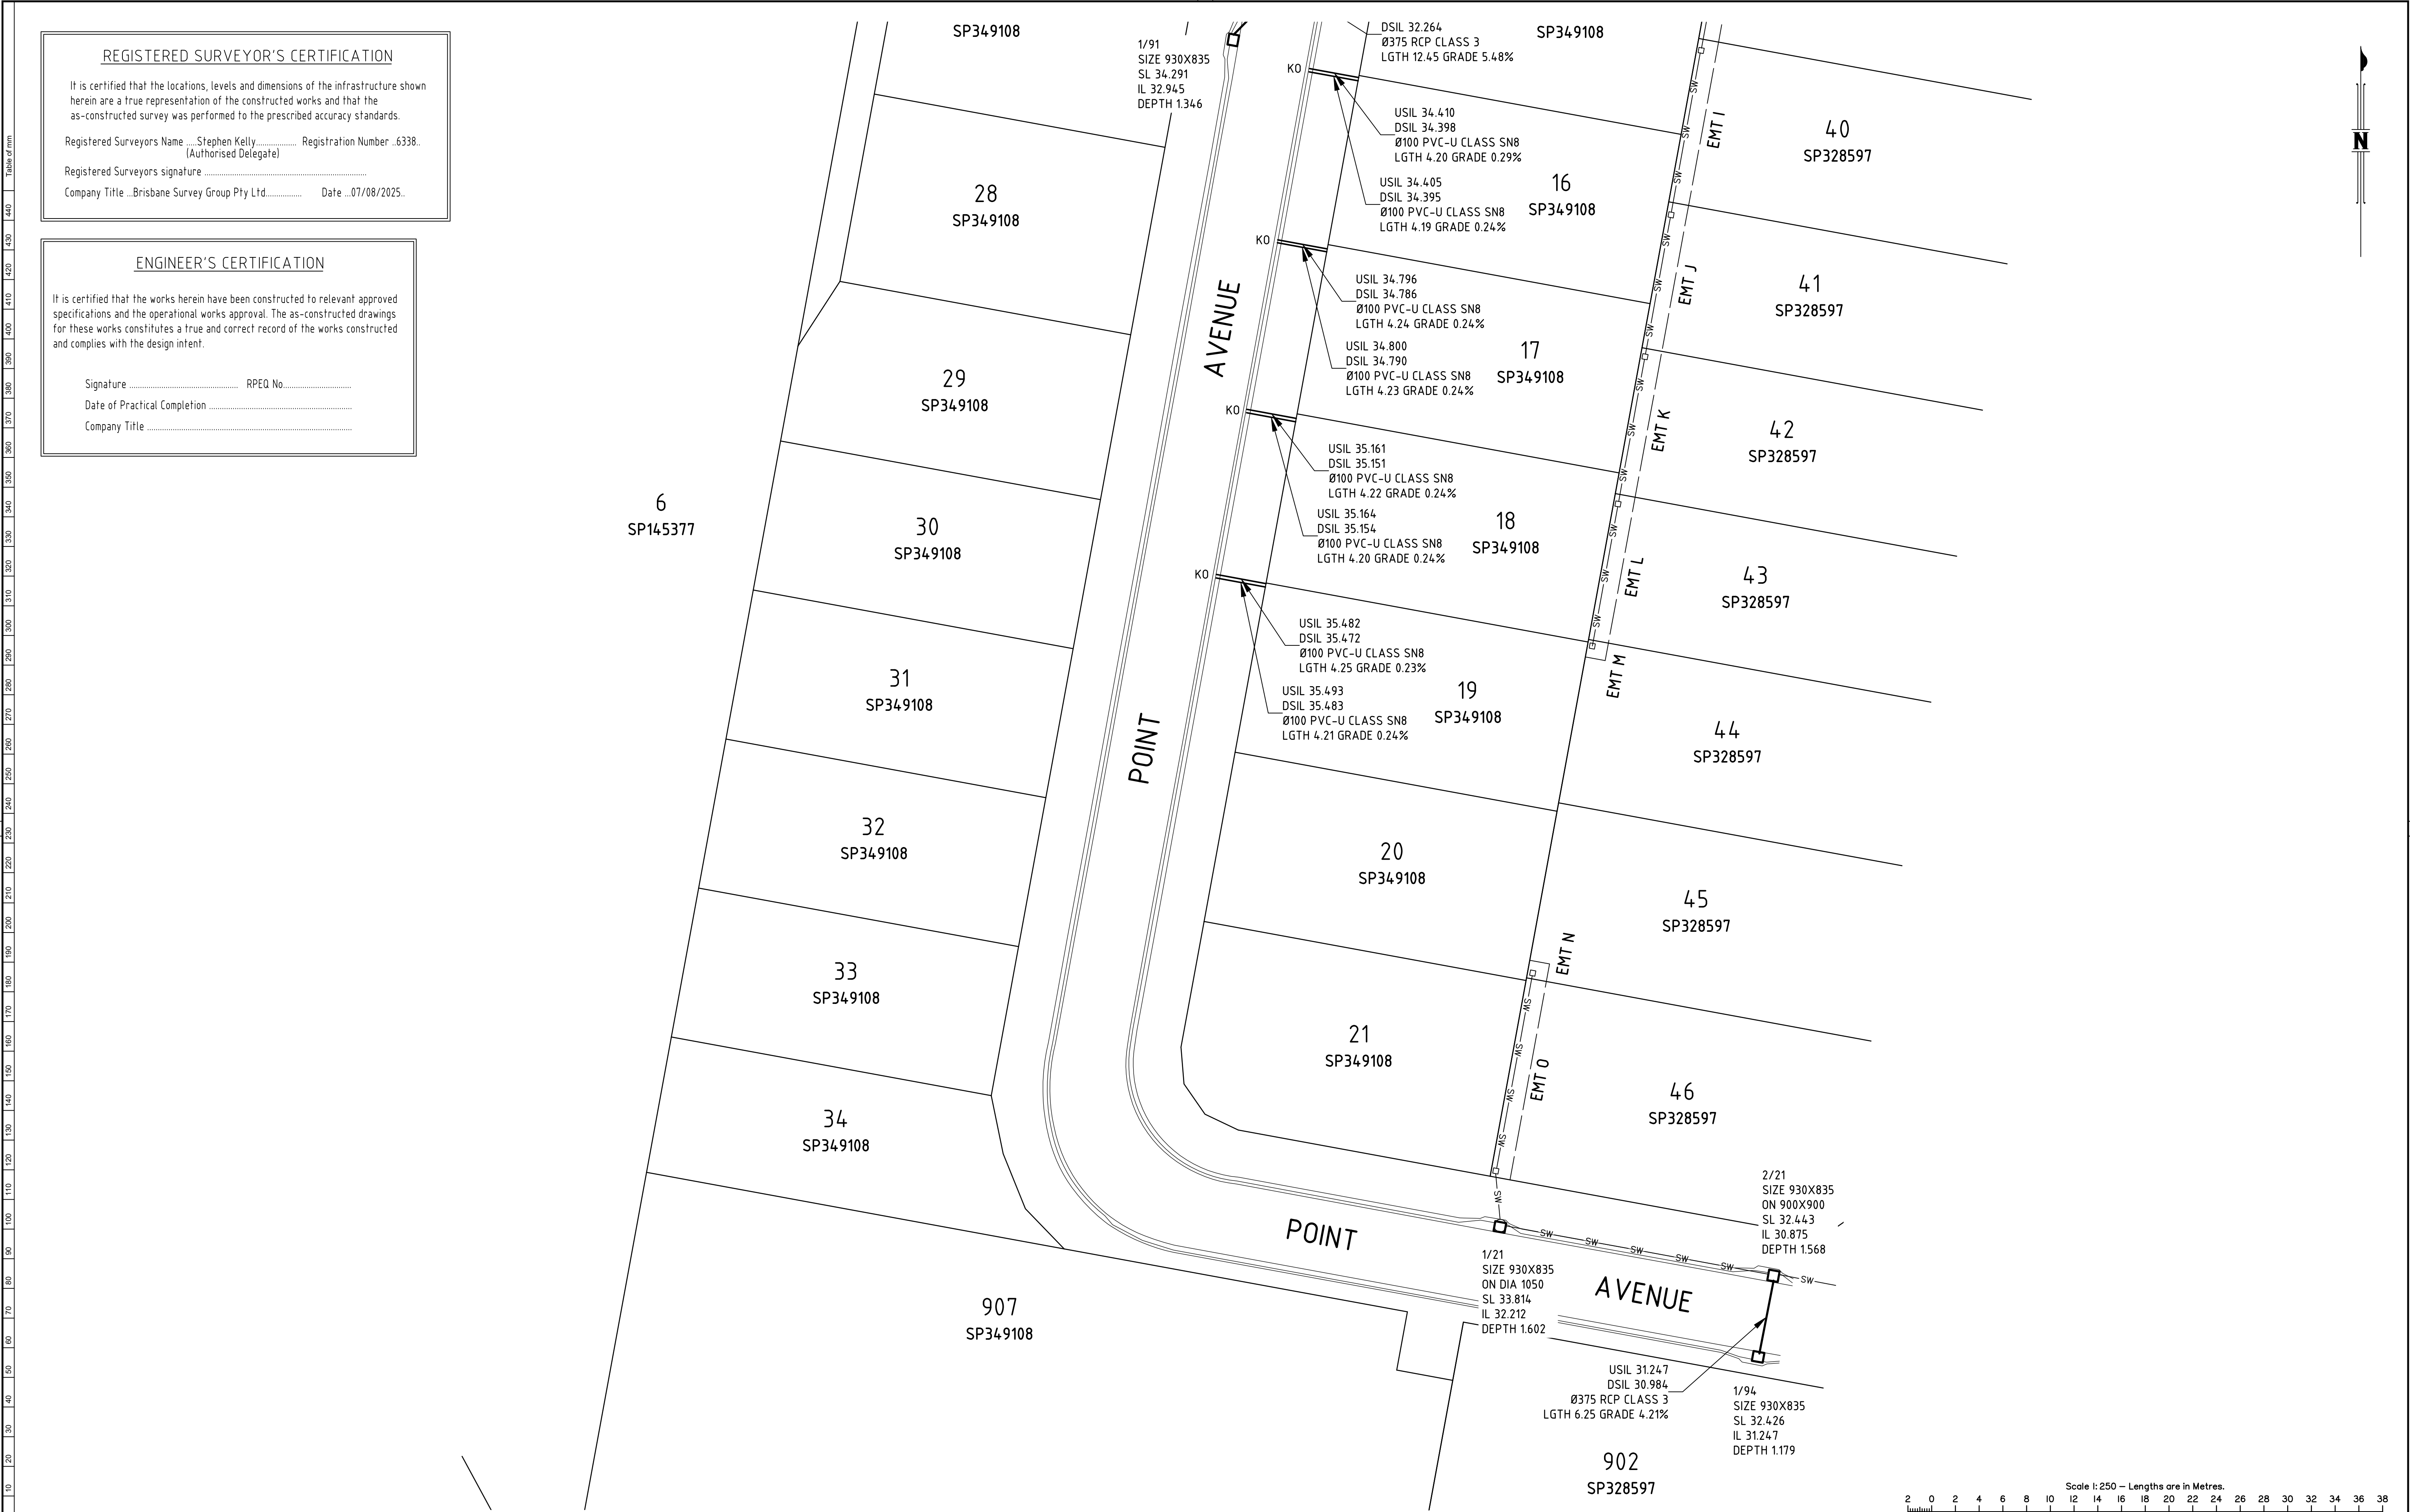

REGISTERED SURVEYOR'S CERTIFICATION

It is certified that the locations, levels and dimensions of the infrastructure shown herein are a true representation of the constructed works and that the as-constructed survey was performed to the prescribed accuracy standards.

Registered Surveyors Name ...Stephen Kelly..... Registration Number ..6338.. (Authorised Delegate)

Registered Surveyors signature .....

Company Title ..Brisbane Survey Group Pty Ltd..... Date ...07/08/2025..

ENGINEER'S CERTIFICATION

It is certified that the works herein have been constructed to relevant approved specifications and the operational works approval. The as-constructed drawings for these works constitutes a true and correct record of the works constructed and complies with the design intent.

Signature ..... RPEQ No.....

Date of Practical Completion .....

Company Title .....

LAWSON SURVEYS



A.B.N 46 272 949 047  
CONSULTING LAND SURVEYORS  
9B / 62 BISHOP STREET  
KELVIN GROVE QLD 4059  
Ph 07 3352 3326 Fax 07 3352 6991  
mail@lawsonsurveys.com.au  
www.lawsonsurveys.com.au

Amendments

| ISSUE | DATE | DETAILS |
|-------|------|---------|
|       |      |         |
|       |      |         |
PLAN:

PLAN OF AS CONSTRUCTED DRAINAGE

CLAY GULLY STAGE 6  
CLAY GULLY ROAD, VICTORIA POINT

OPW NUMBER:

OPW /

LGA:

REDLAND CITY COUNCIL

SUBURB:

VICTORIA POINT

ORIGIN:

MGA

SCALE:

1:250

DATUM:

AHD

DATE OF SURVEY:

22/07/2025


SURVEYED BY:

LAWSON SURVEYS

DRAWN BY:

QSD

Scale 1:250 – Lengths are in Metres.

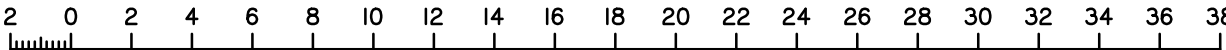

CLIENT:

URBEX

PLAN REFERENCE:

20361-6-SW

ISSUE

INT

SHEET

3 OF 3