REGISTERED SURVEYOR'S CERTIFICATION

It is certified that the locations, levels and dimensions of the infrastructure shown herein are a true representation of the constructed works and that the as-constructed survey was performed to the prescribed accuracy standards.

Registered Surveyors Name .....Stephen Kelly..... (Authorised Delegate) Registration Number ..6338..

Registered Surveyors signature .....

Company Title ...Brisbane Survey Group Pty Ltd..... Date ...08/11/2021..

AS-CONSTRUCTED WORKS

IT IS CERTIFIED THAT WORKS HEREIN HAVE BEEN CONSTRUCTED TO RELEVANT APPROVED SPECIFICATIONS AND THE OPERATIONAL WORKS APPROVAL. THE AS-CONSTRUCTED DRAWINGS FOR THESE WORKS CONSTITUES A TRUE AND CORRECT RECORD OF THE WORKS CONSTRUCTED AND COMPLIES WITH THE DESIGN INTENT.

SIGNATURE..... RPEQ No. 9424

DATE OF PRACTICAL COMPLETION..... 11/11/2021

COMPANY TITLE..EMPOWER ENGINEERS AND PROJECT MANAGERS.....

NOTE: ALL AS CONSTRUCTED INFORMATION SHOWN IN RED AND DENOTED WITH AN "x"

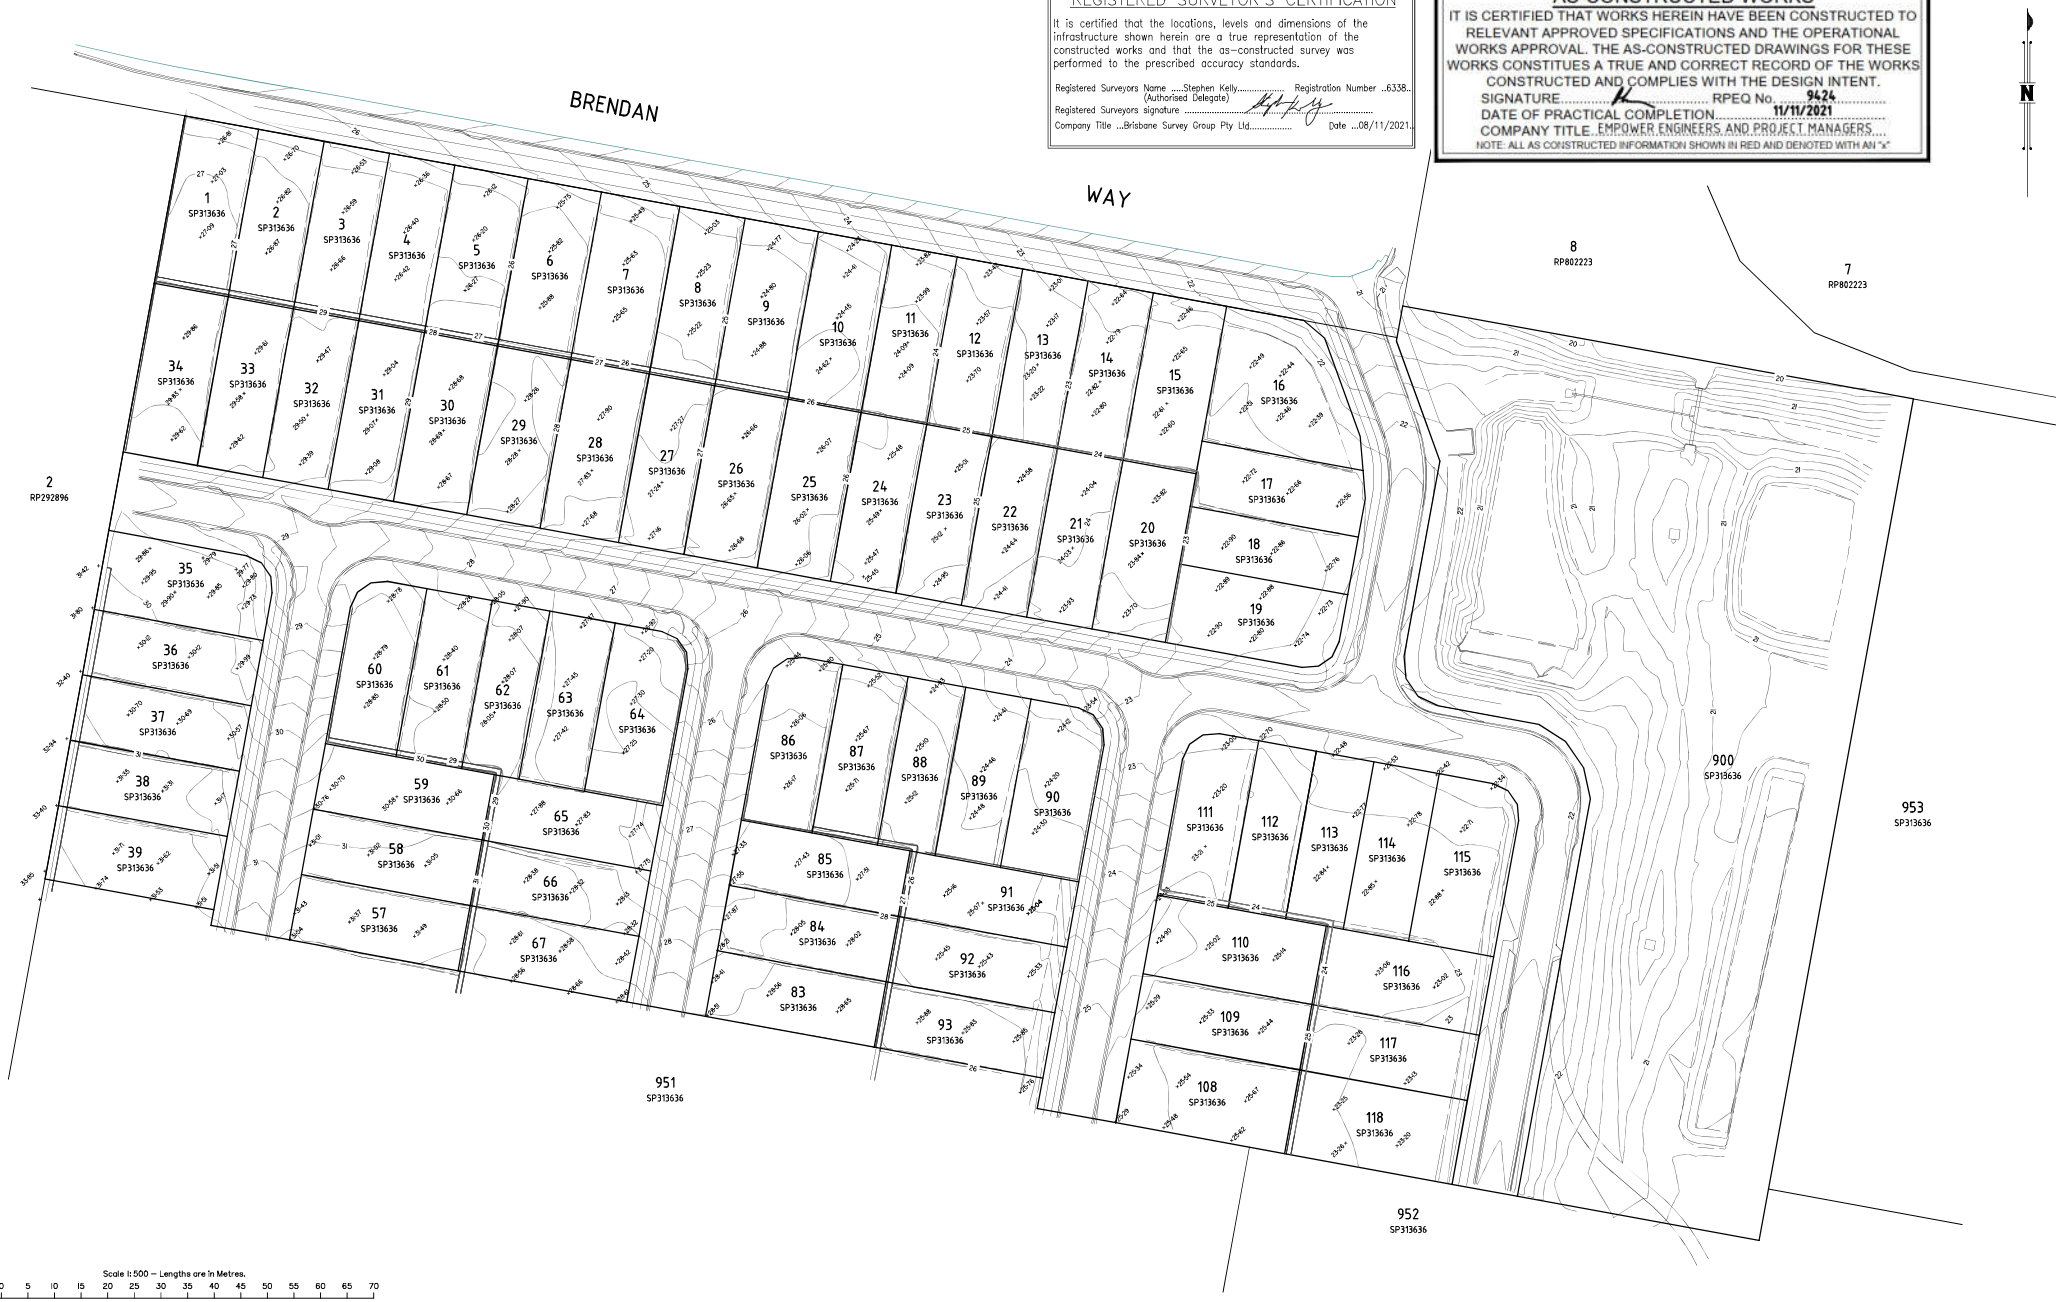

Scale 1:500 – Lengths are in Metres.

5 0 5 10 15 20 25 30 35 40 45 50 55 60 65 70

NOTES:

LAWSON SURVEYS
A.B.N 46 272 949 047
CONSULTING LAND SURVEYORS
9B / 62 BISHOP STREET
KELVIN GROVE QLD 4059
Ph 07 3352 3326 Fax 07 3352 6991
mail@lawsonsurveys.com.au
www.lawsonsurveys.com.au

Amendments

ISSUE	DATE	DETAILS
A	26/09/2021	INITIAL VERSION
B	26/10/2021	ADDITIONAL LEVEL INFORMATION ADDED
C	08/11/2021	ADDITIONAL LEVEL INFORMATION ADDED

PLAN:

PLAN OF AS CONSTRUCTED ROADS & SURFACE LEVELS

GLAY GULLY STAGE 1
GLAY GULLY ROAD, VICTORIA POINT

OPW NUMBER: -
LGA: REDLAND CITY COUNCIL
SUBURB: VICTORIA POINT
ORIGIN: MGA

SCALE: 1:500
DATUM: AHD
DATE OF SURVEY: 03/09/2021
SURVEYED BY: LAWSON SURVEYS
DRAWN BY: QSD

CLIENT: URBEX
ISSUE: C
PLAN REFERENCE: 20361-1-ROADS
SHEET: 1 OF 1