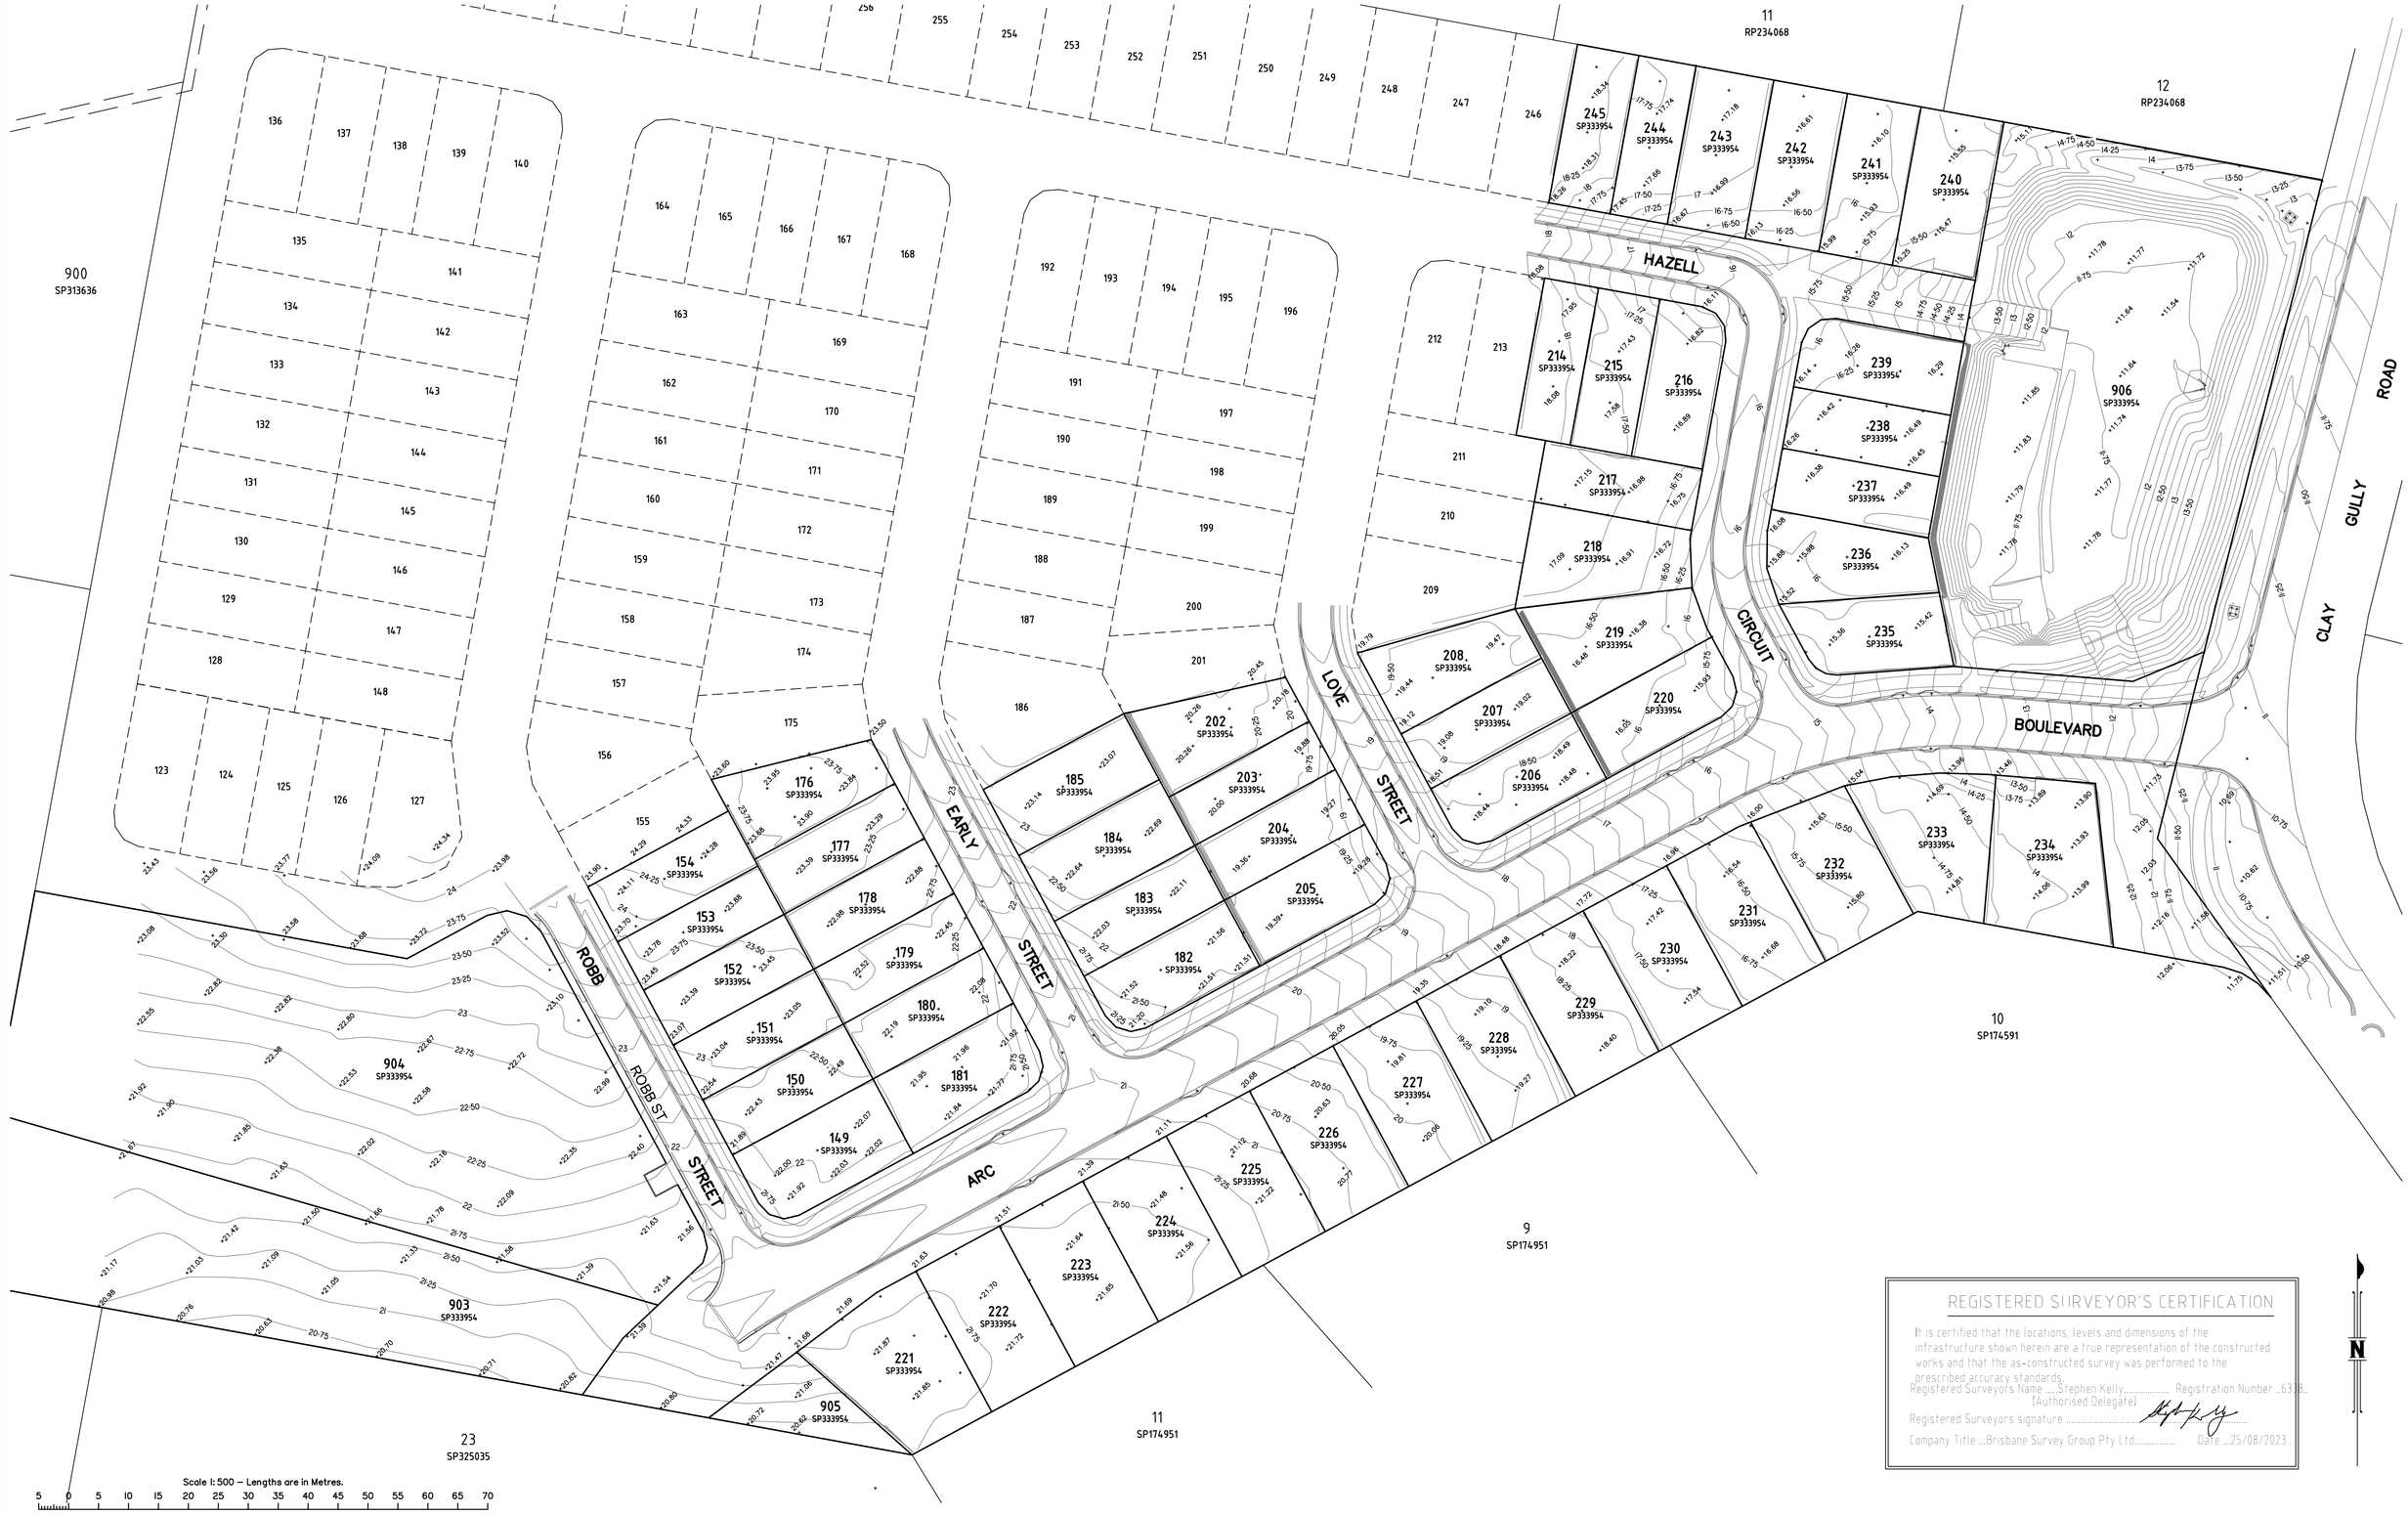

REGISTERED SURVEYOR'S CERTIFICATION

It is certified that the locations, levels and dimensions of the infrastructure shown herein are a true representation of the constructed works and that the as-constructed survey was performed to the prescribed accuracy standards.

Registered Surveyors Name .....Stephen Kelly..... Registration Number ...6318...
(Authorised Delegate)

Registered Surveyors signature .....

Company Title ...Brisbane Survey Group Pty Ltd..... Date ...25/08/2023...

NOTES:

LAWSON SURVEYS
A.B.N 46 272 949 047
CONSULTING LAND SURVEYORS
9B / 62 BISHOP STREET
KELVIN GROVE QLD 4059
Ph 07 3352 3326 Fax 07 3352 6991
mail@lawsonsurveys.com.au
www.lawsonsurveys.com.au

Amendments

ISSUE	DATE	DETAILS
A	11/05/2023	INITIAL VERSION
B	25/08/2023	LOTS 903-905 UPDATED

PLAN:

PLAN OF AS CONSTRUCTED ROADS & SURFACE LEVELS

CLAY GULLY STAGE 3
CLAY GULLY ROAD, VICTORIA POINT

OPW NUMBER:	-
LGA:	REDLAND CITY COUNCIL
SUBURB:	VICTORIA POINT
ORIGIN:	MGA
SCALE:	1:500
DATUM:	AHD
DATE OF SURVEY:	3/2023
SURVEYED BY:	LAWSON SURVEYS
DRAWN BY:	QSD
CLIENT:	URBEX
ISSUE	B
PLAN REFERENCE:	20361-3-ROADS
SHEET	1 OF 1