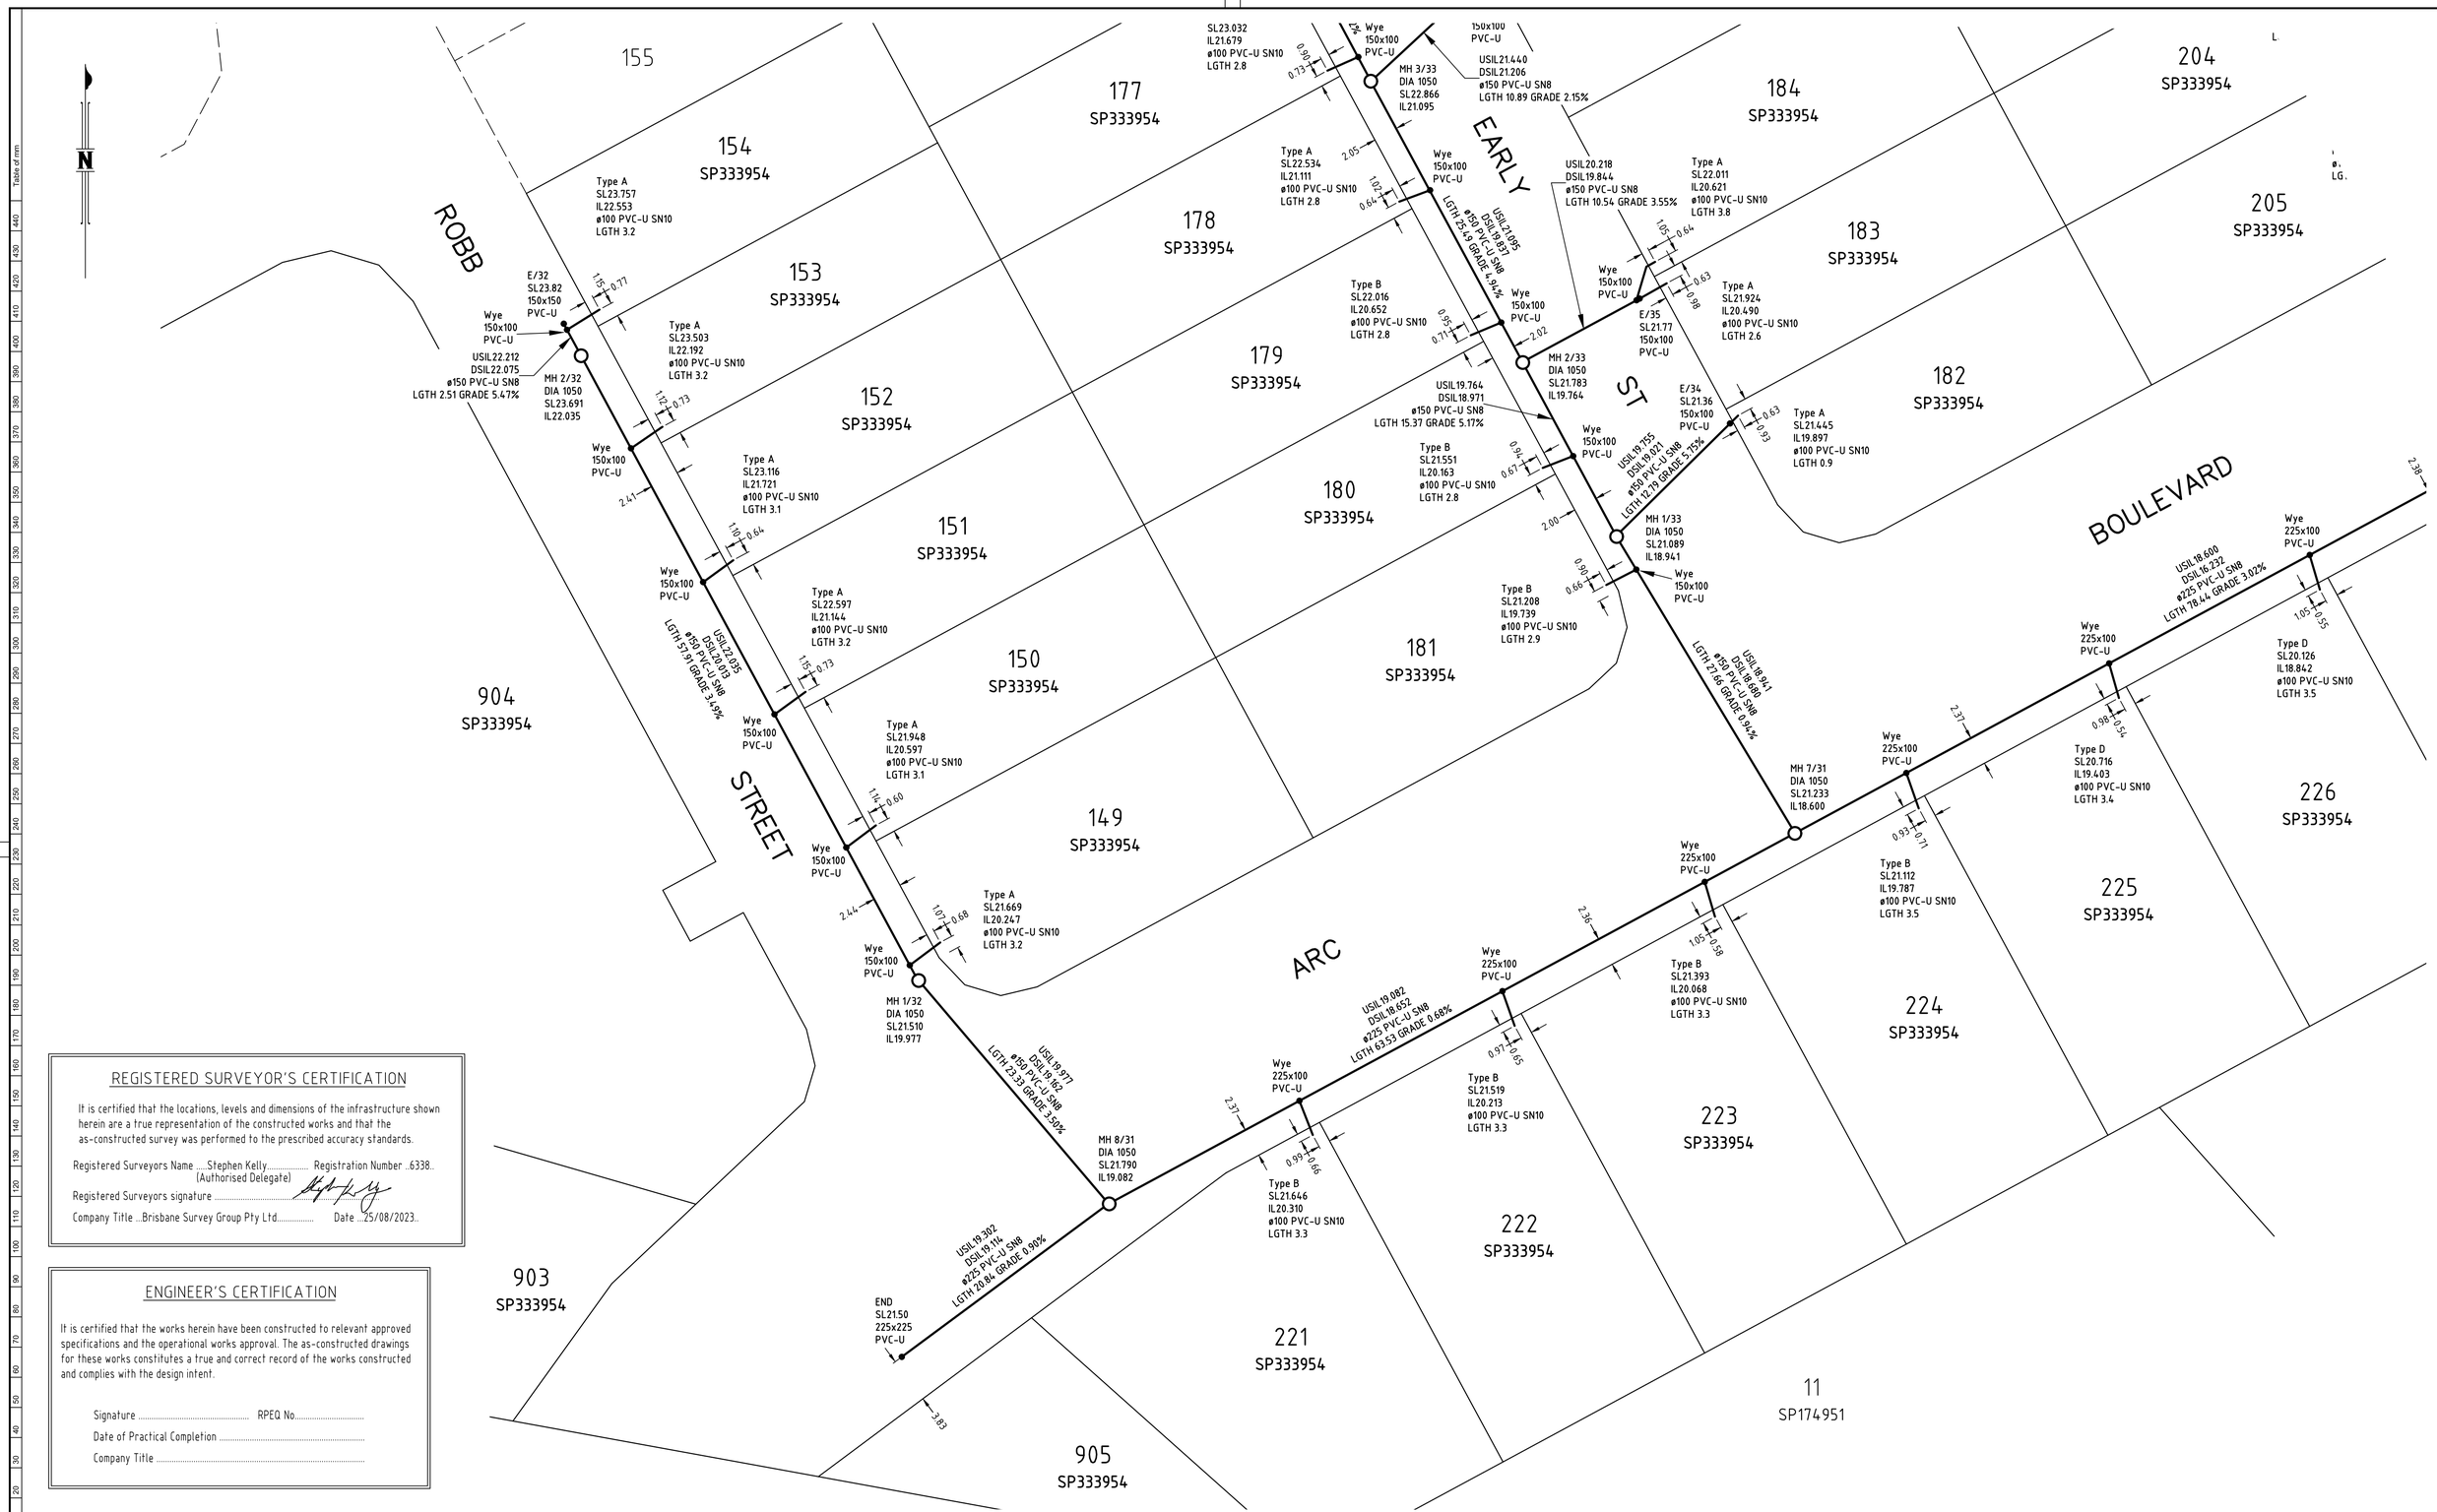

REGISTERED SURVEYOR'S CERTIFICATION

It is certified that the locations, levels and dimensions of the infrastructure shown herein are a true representation of the constructed works and that the as-constructed survey was performed to the prescribed accuracy standards.

Registered Surveyors Name ....Stephen Kelly..... Registration Number ..6338..
(Authorised Delegate)

Registered Surveyors signature .....

Company Title ...Brisbane Survey Group Pty Ltd..... Date ...25/08/2023..

ENGINEER'S CERTIFICATION

It is certified that the works herein have been constructed to relevant approved specifications and the operational works approval. The as-constructed drawings for these works constitutes a true and correct record of the works constructed and complies with the design intent.

Signature ..... RPEQ No.....

Date of Practical Completion .....

Company Title .....

Scale 1:250 — Lengths are in Metres.

2 0 2 4 6 8 10 12 14 16 18 20 22 24 26 28 30 32 34 36 38

NOTES:

LAWSON SURVEYS
A.B.N 46 272 949 047
CONSULTING LAND SURVEYORS
9B / 62 BISHOP STREET
KELVIN GROVE QLD 4059
Ph 07 3352 3326 Fax 07 3352 6991
mail@lawsonsurveys.com.au
www.lawsonsurveys.com.au

Amendments

ISSUE	DATE	DETAILS
A	27/03/2023	INITIAL VERSION
B	16/04/2023	UPDATED ISSUE
C	26/04/2023	UPDATED ISSUE
D	25/08/2023	LOTS 903-905 UPDATED

PLAN:

PLAN OF AS CONSTRUCTED SEWER

CLAY GULLY STAGE 3
CLAY GULLY ROAD, VICTORIA POINT

OPW NUMBER:	OPW /
LGA:	REDLAND CITY COUNCIL
SUBURB:	VICTORIA POINT
ORIGIN:	MGA
SCALE:	1:250
DATUM:	AHD
DATE OF SURVEY:	28/02/2023
SURVEYED BY:	LAWSON SURVEYS
DRAWN BY:	QSD
CLIENT:	URBEX
ISSUE	D
PLAN REFERENCE:	20361B-3-WATER
SHEET	1 OF 5

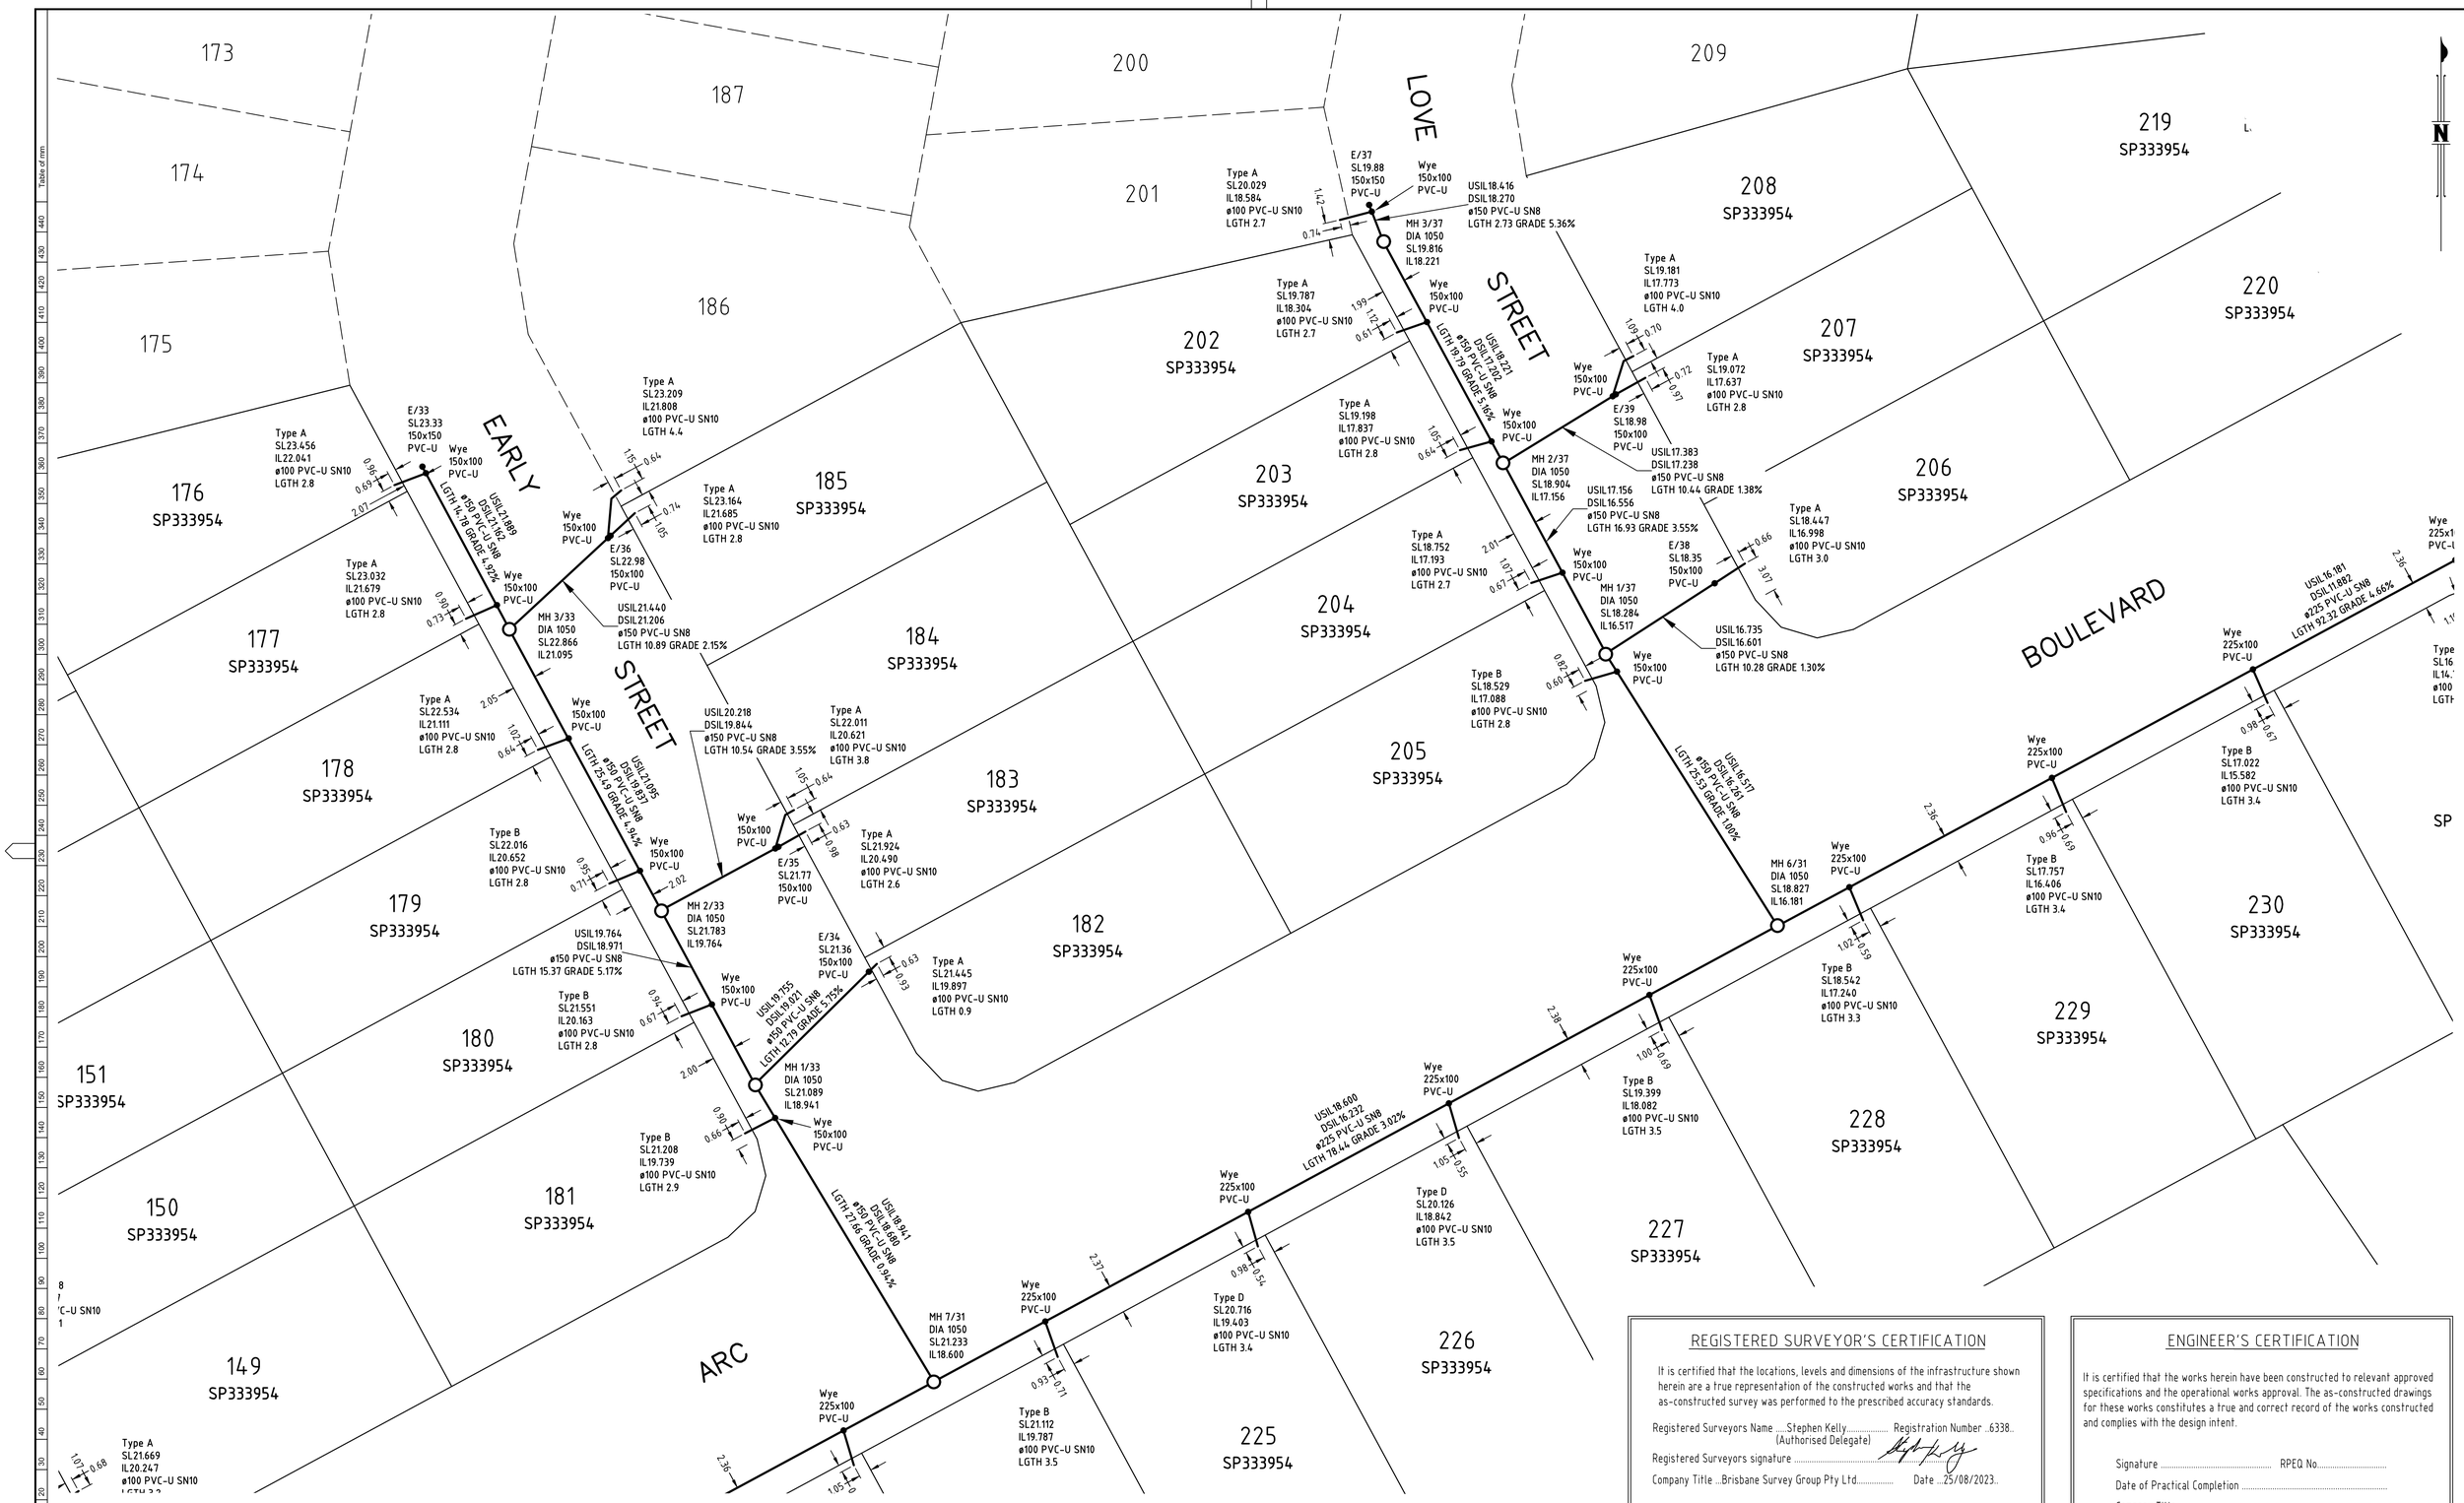

Scale 1:250 – Lengths are in Metres.

2 0 2 4 6 8 10 12 14 16 18 20 22 24 26 28 30 32 34 36 38

NOTES:

REGISTERED SURVEYOR'S CERTIFICATION

It is certified that the locations, levels and dimensions of the infrastructure shown herein are a true representation of the constructed works and that the as-constructed survey was performed to the prescribed accuracy standards.

Registered Surveyors Name ....Stephen Kelly..... Registration Number ..6338..
(Authorised Delegate)

Registered Surveyors signature .....

Company Title ...Brisbane Survey Group Pty Ltd..... Date ...25/08/2023..

ENGINEER'S CERTIFICATION

It is certified that the works herein have been constructed to relevant approved specifications and the operational works approval. The as-constructed drawings for these works constitutes a true and correct record of the works constructed and complies with the design intent.

Signature ..... RPEQ No.....

Date of Practical Completion .....

Company Title .....

LAWSON SURVEYS
A.B.N 46 272 949 047
CONSULTING LAND SURVEYORS
9B / 62 BISHOP STREET
KELVIN GROVE QLD 4059
Ph 07 3352 3326 Fax 07 3352 6991
mail@lawsonsurveys.com.au
www.lawsonsurveys.com.au

Amendments

ISSUE	DATE	DETAILS
A	27/03/2023	INITIAL VERSION
B	16/04/2023	UPDATED ISSUE
C	26/04/2023	UPDATED ISSUE
D	25/08/2023	LOTS 903-905 UPDATED

PLAN:

PLAN OF AS CONSTRUCTED SEWER

CLAY GULLY STAGE 3
CLAY GULLY ROAD, VICTORIA POINT

OPW NUMBER:	OPW /
LGA:	REDLAND CITY COUNCIL
SUBURB:	VICTORIA POINT
ORIGIN:	MGA
SCALE:	1:250
DATUM:	AHD
DATE OF SURVEY:	28/02/2023
SURVEYED BY:	LAWSON SURVEYS
DRAWN BY:	QSD
CLIENT:	URBEX
ISSUE	D
PLAN REFERENCE:	20361B-3-WATER
SHEET	2 OF 5

REGISTERED SURVEYOR'S CERTIFICATION

It is certified that the locations, levels and dimensions of the infrastructure shown herein are a true representation of the constructed works and that the as-constructed survey was performed to the prescribed accuracy standards.

Registered Surveyors Name .....Stephen Kelly..... Registration Number ..6338..
(Authorised Delegate)

Registered Surveyors signature .....

Company Title ...Brisbane Survey Group Pty Ltd..... Date ...25/08/2023..

ENGINEER'S CERTIFICATION

It is certified that the works herein have been constructed to relevant approved specifications and the operational works approval. The as-constructed drawings for these works constitutes a true and correct record of the works constructed and complies with the design intent.

Signature ..... RPEQ No.....

Date of Practical Completion .....

Company Title .....

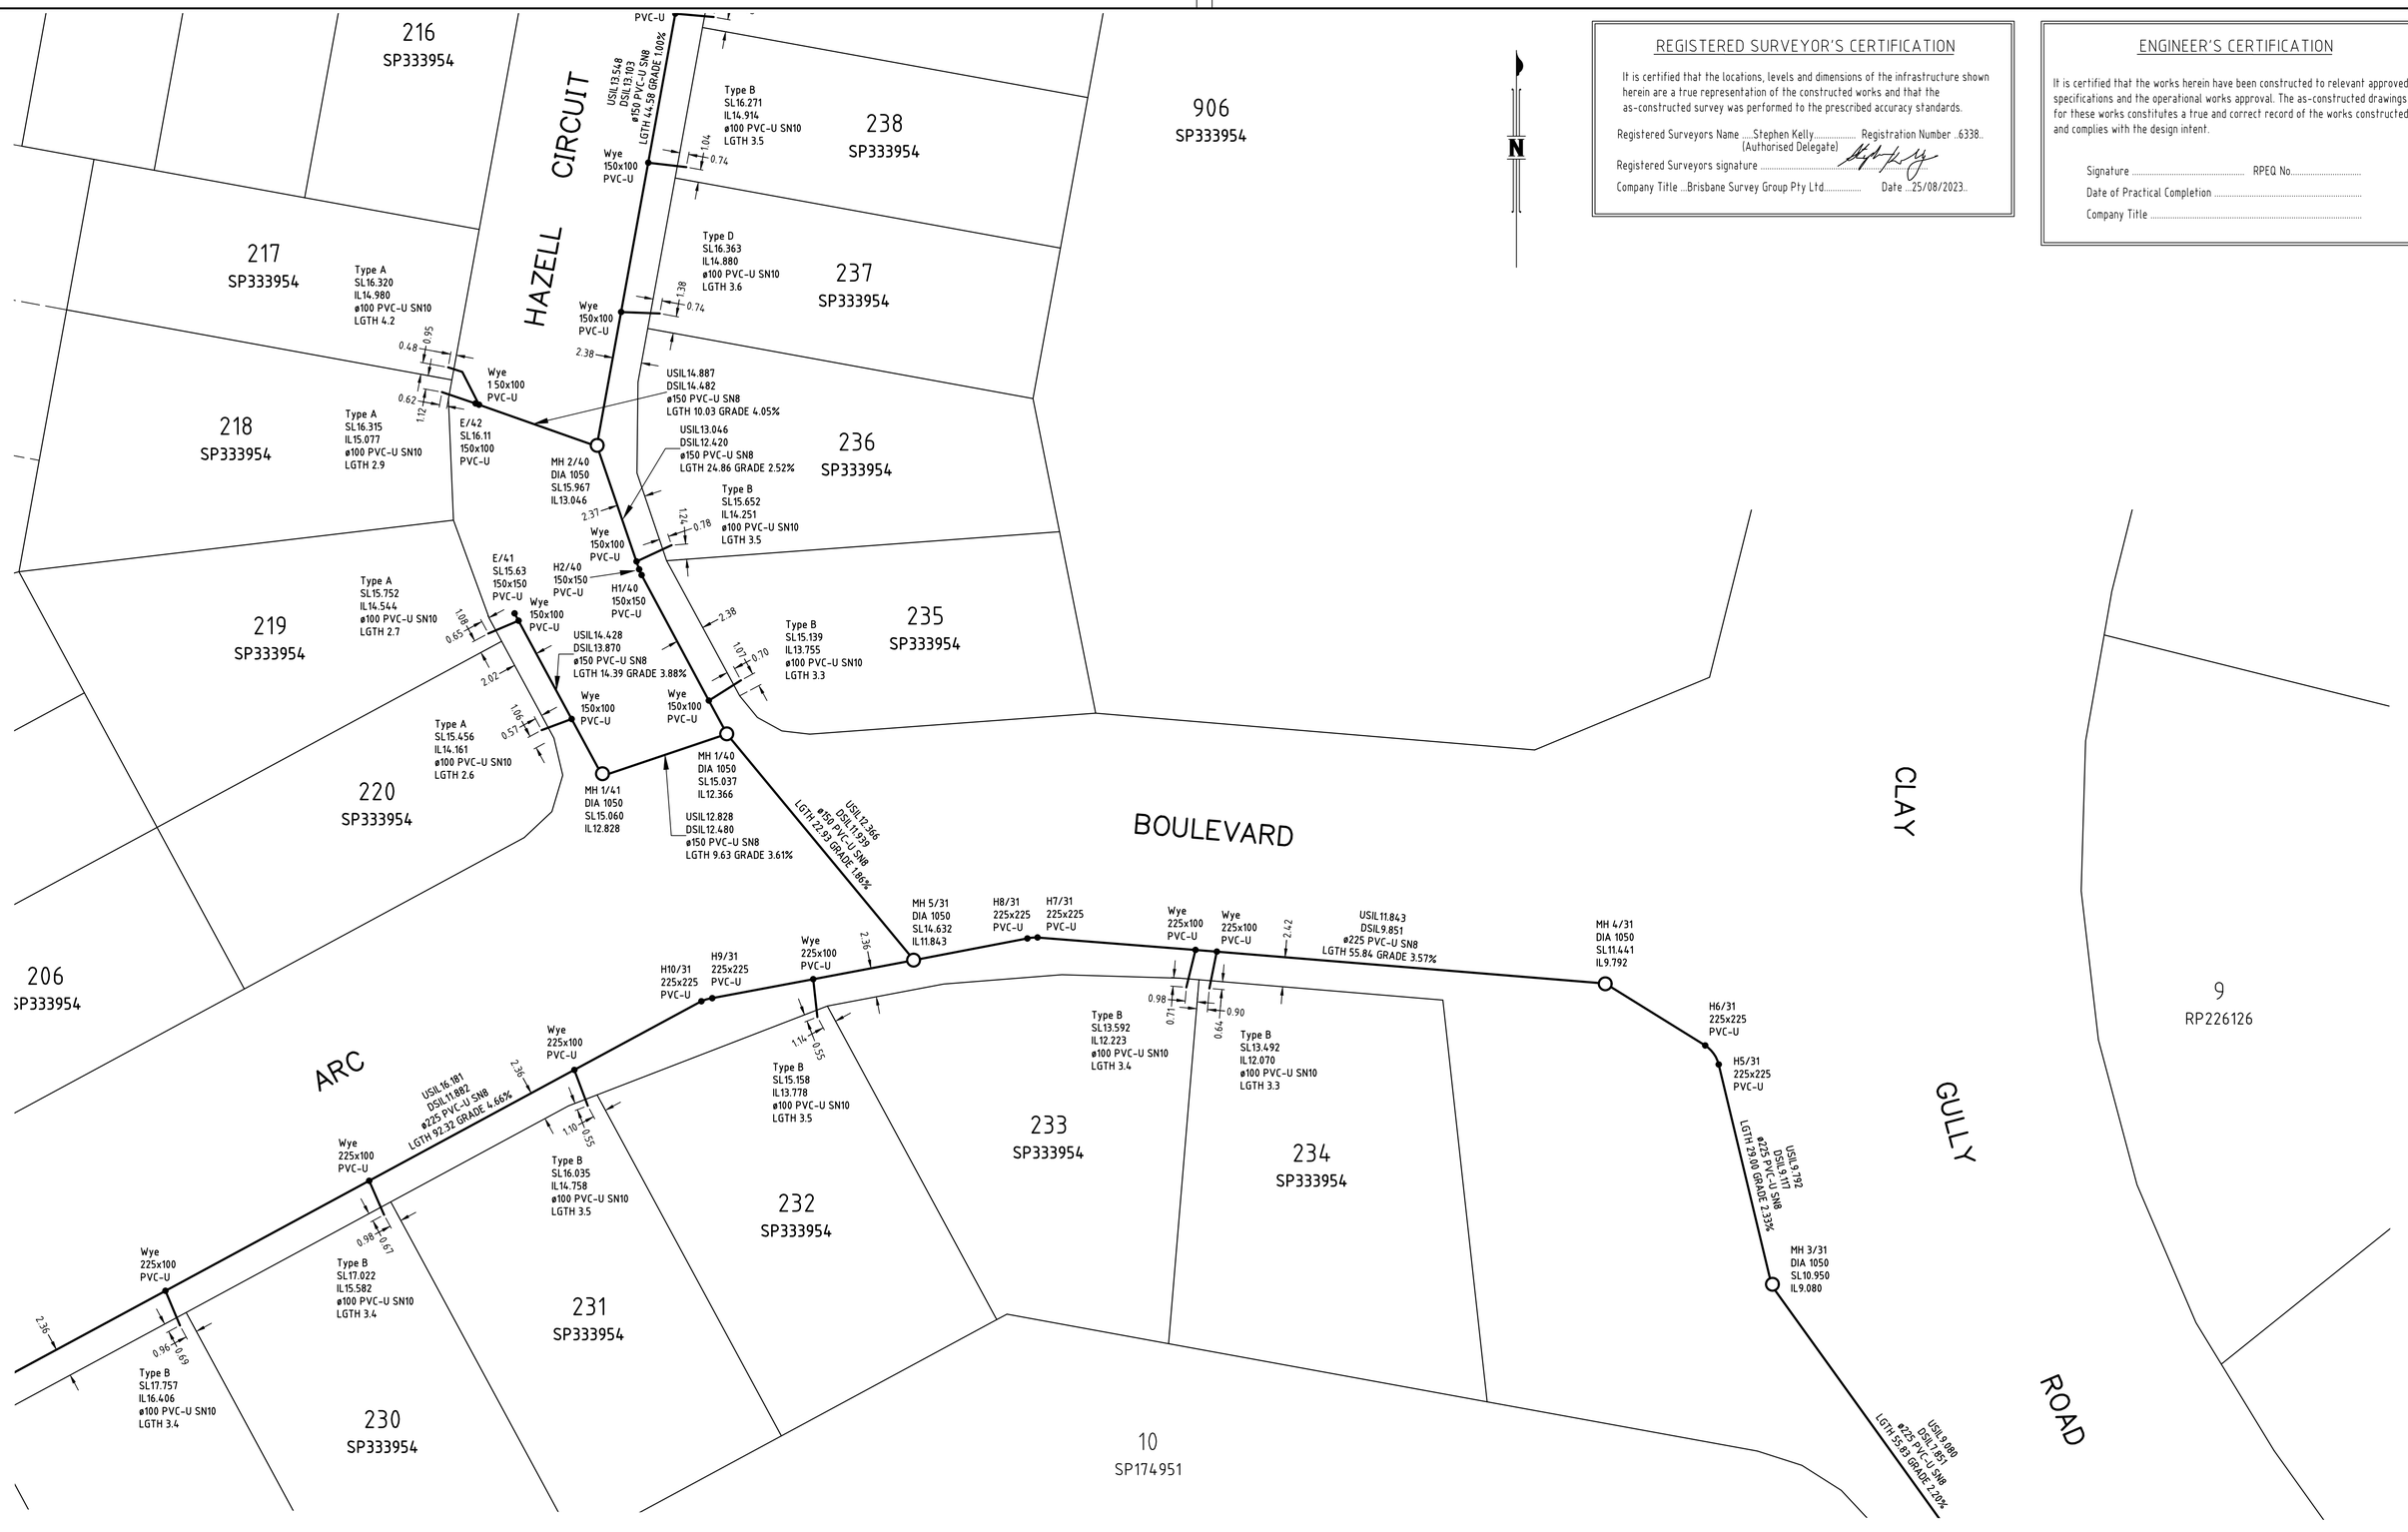

Scale 1:250 – Lengths are in Metres.

2 0 2 4 6 8 10 12 14 16 18 20 22 24 26 28 30 32 34 36 38

NOTES:

LAWSON SURVEYS
A.B.N 46 272 949 047
CONSULTING LAND SURVEYORS
9B / 62 BISHOP STREET
KELVIN GROVE QLD 4059
Ph 07 3352 3326 Fax 07 3352 6991
mail@lawsonsurveys.com.au
www.lawsonsurveys.com.au

Amendments

ISSUE	DATE	DETAILS
A	27/03/2023	INITIAL VERSION
B	16/04/2023	UPDATED ISSUE
C	26/04/2023	UPDATED ISSUE
D	25/08/2023	LOTS 903-905 UPDATED

PLAN:

PLAN OF AS CONSTRUCTED SEWER

CLAY GULLY STAGE 3
CLAY GULLY ROAD, VICTORIA POINT

OPW NUMBER:	OPW /
LGA:	REDLAND CITY COUNCIL
SUBURB:	VICTORIA POINT
ORIGIN:	MGA
SCALE:	1:250
DATUM:	AHD
DATE OF SURVEY:	28/02/2023
SURVEYED BY:	LAWSON SURVEYS
DRAWN BY:	QSD
CLIENT:	URBEX
ISSUE	D
PLAN REFERENCE:	20361B-3-WATER
SHEET	3 OF 5

ENGINEER'S CERTIFICATION

It is certified that the works herein have been constructed to relevant approved specifications and the operational works approval. The as-constructed drawings for these works constitutes a true and correct record of the works constructed and complies with the design intent.

Signature ..... RPEQ No.....

Date of Practical Completion .....

Company Title .....

REGISTERED SURVEYOR'S CERTIFICATION

It is certified that the locations, levels and dimensions of the infrastructure shown herein are a true representation of the constructed works and that the as-constructed survey was performed to the prescribed accuracy standards.

Registered Surveyors Name ....Stephen Kelly..... Registration Number ..6338..
(Authorised Delegate)

Registered Surveyors signature .....

Company Title ...Brisbane Survey Group Pty Ltd..... Date ...25/08/2023..

Scale 1:250 – Lengths are in Metres.

2 0 2 4 6 8 10 12 14 16 18 20 22 24 26 28 30 32 34 36 38

NOTES:

LAWSON SURVEYS
A.B.N 46 272 949 047
CONSULTING LAND SURVEYORS
9B / 62 BISHOP STREET
KELVIN GROVE QLD 4059
Ph 07 3352 3326 Fax 07 3352 6991
mail@lawsonsurveys.com.au
www.lawsonsurveys.com.au

Amendments

ISSUE	DATE	DETAILS
A	27/03/2023	INITIAL VERSION
B	16/04/2023	UPDATED ISSUE
C	26/04/2023	UPDATED ISSUE
D	25/08/2023	LOTS 903-905 UPDATED

PLAN:

PLAN OF AS CONSTRUCTED SEWER

CLAY GULLY STAGE 3
CLAY GULLY ROAD, VICTORIA POINT

OPW NUMBER:	OPW /
LGA:	REDLAND CITY COUNCIL
SUBURB:	VICTORIA POINT
ORIGIN:	MGA
SCALE:	1:250
DATUM:	AHD
DATE OF SURVEY:	28/02/2023
SURVEYED BY:	LAWSON SURVEYS
DRAWN BY:	QSD
CLIENT:	URBEX
ISSUE	D
PLAN REFERENCE:	20361B-3-WATER
SHEET	4 OF 5

REGISTERED SURVEYOR'S CERTIFICATION

It is certified that the locations, levels and dimensions of the infrastructure shown herein are a true representation of the constructed works and that the as-constructed survey was performed to the prescribed accuracy standards.

Registered Surveyors Name ....Stephen Kelly..... Registration Number ..6338..
(Authorised Delegate)

Registered Surveyors signature .....

Company Title ...Brisbane Survey Group Pty Ltd..... Date ...25/08/2023..

ENGINEER'S CERTIFICATION

It is certified that the works herein have been constructed to relevant approved specifications and the operational works approval. The as-constructed drawings for these works constitutes a true and correct record of the works constructed and complies with the design intent.

Signature ..... RPEQ No.....

Date of Practical Completion .....

Company Title .....

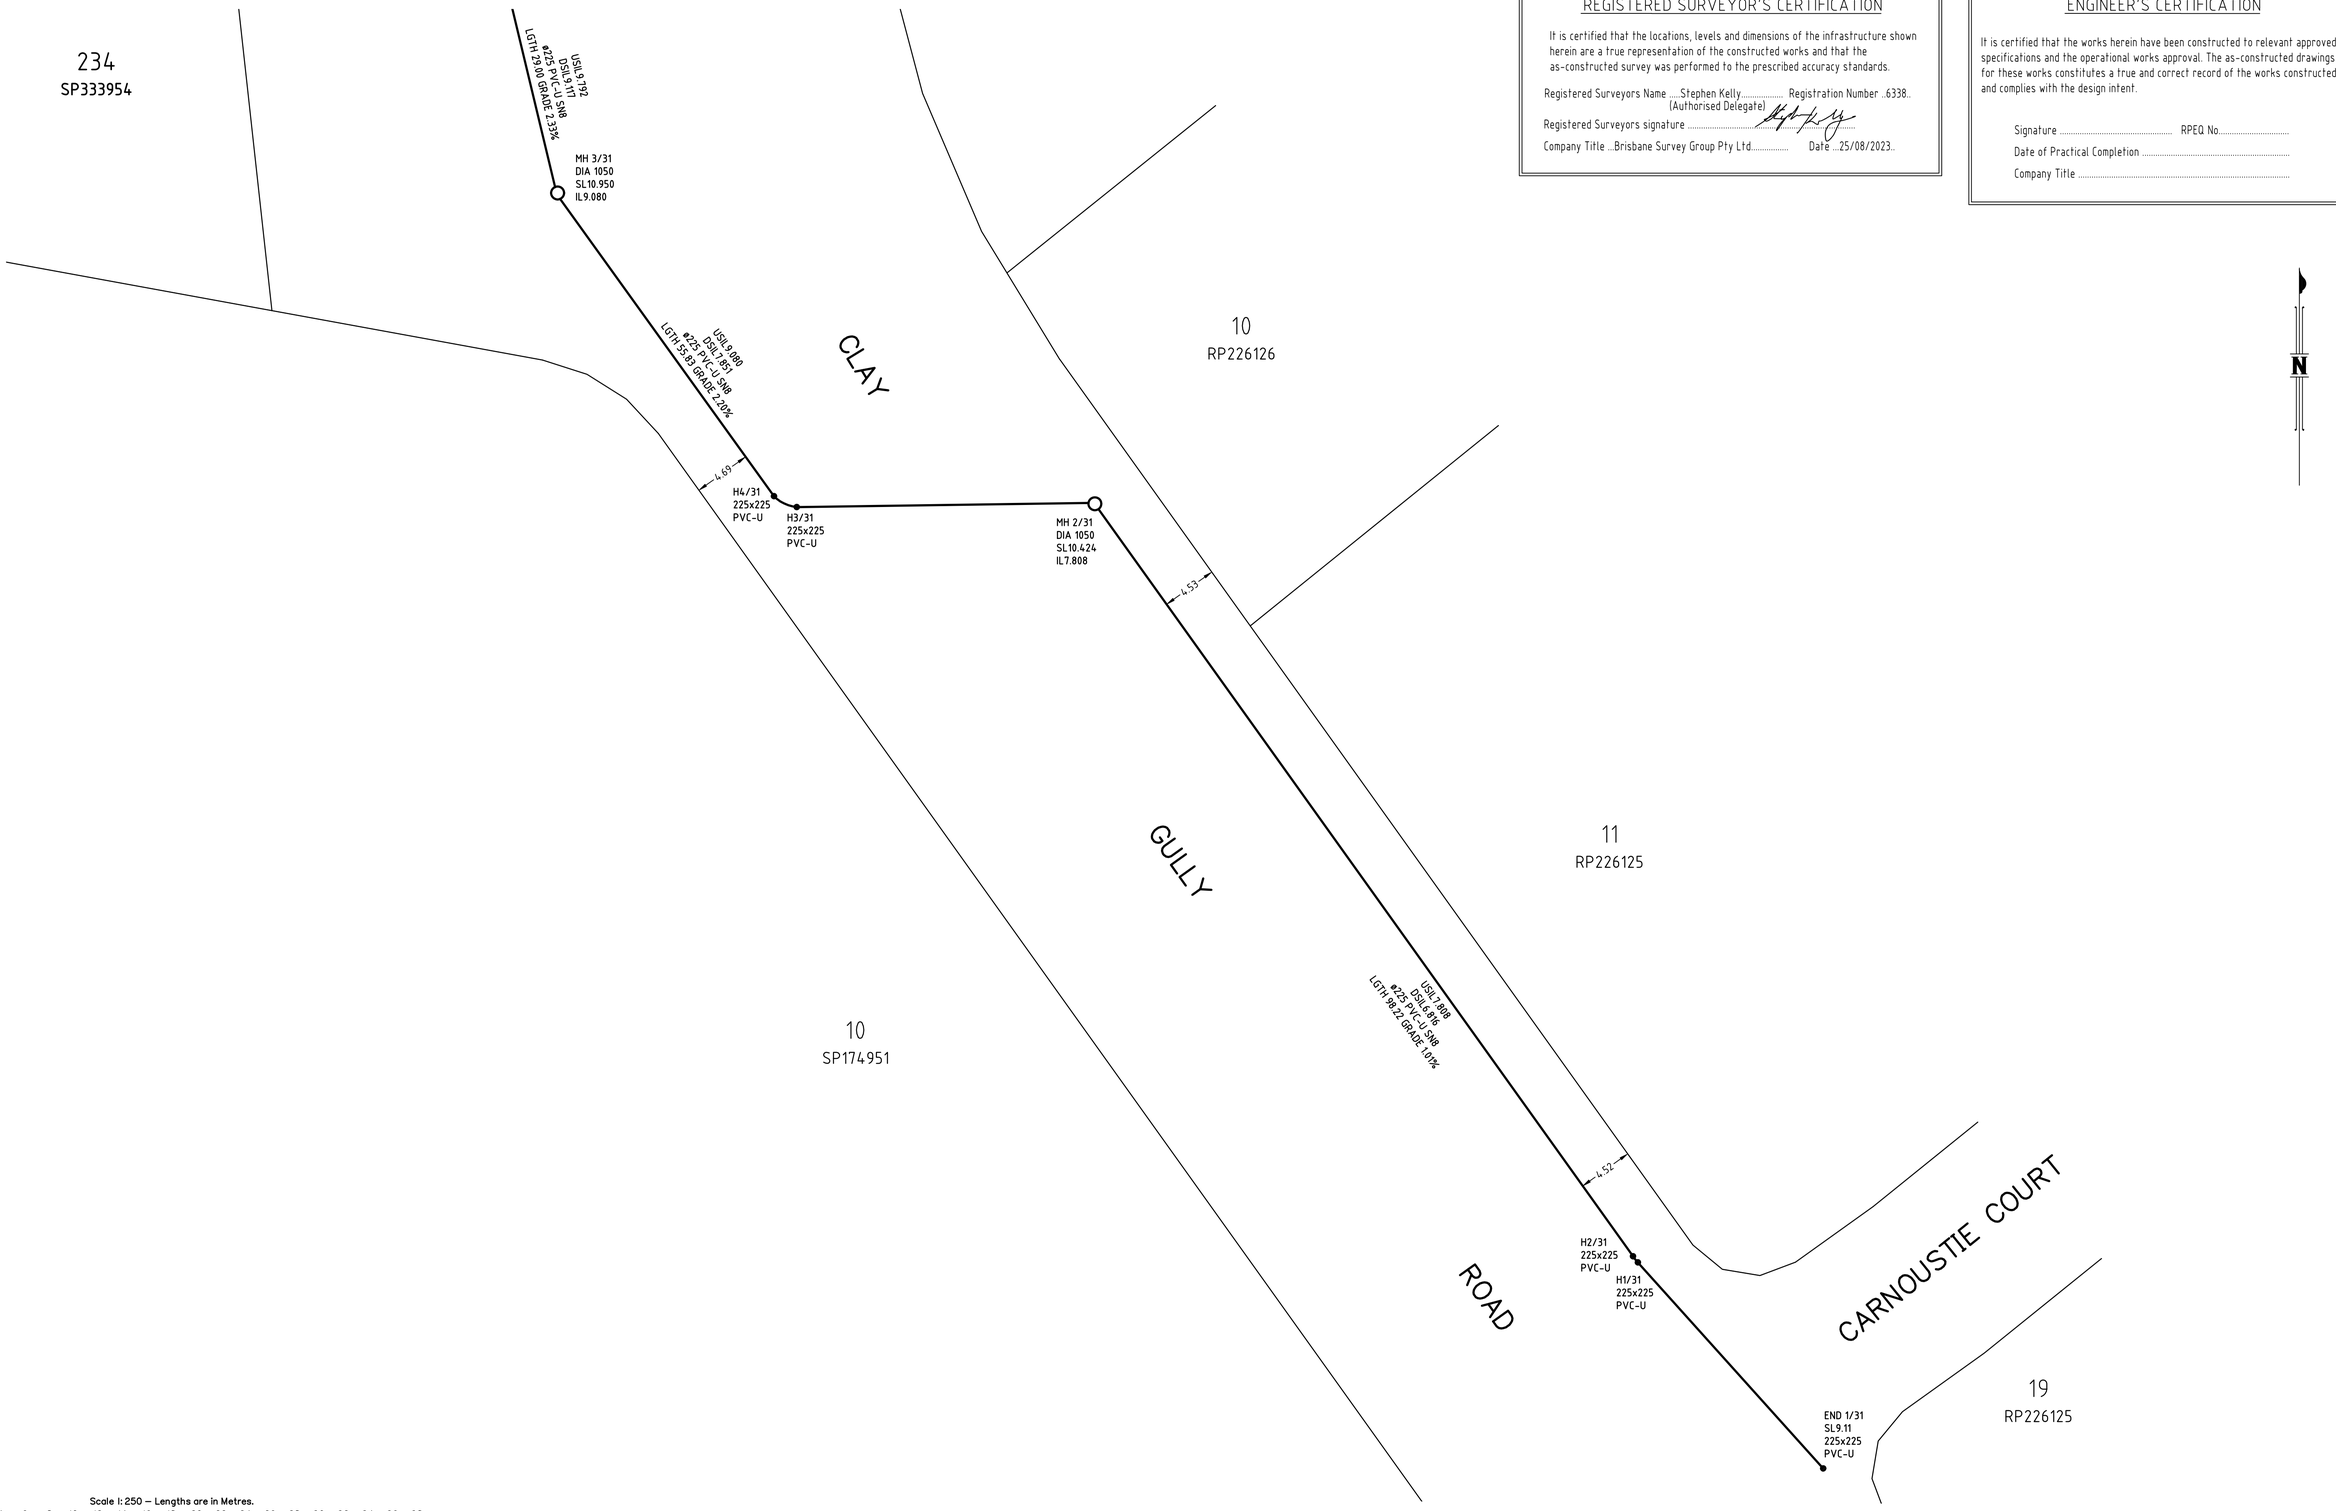

Scale 1:250 – Lengths are in Metres.

2 0 2 4 6 8 10 12 14 16 18 20 22 24 26 28 30 32 34 36 38

NOTES:

LAWSON SURVEYS
A.B.N 46 272 949 047
CONSULTING LAND SURVEYORS
9B / 62 BISHOP STREET
KELVIN GROVE QLD 4059
Ph 07 3352 3326 Fax 07 3352 6991
mail@lawsonsurveys.com.au
www.lawsonsurveys.com.au

Amendments

ISSUE	DATE	DETAILS
A	27/03/2023	INITIAL VERSION
B	16/04/2023	UPDATED ISSUE
C	26/04/2023	UPDATED ISSUE
D	25/08/2023	LOTS 903-905 UPDATED

PLAN:

PLAN OF AS CONSTRUCTED SEWER

CLAY GULLY STAGE 3
CLAY GULLY ROAD, VICTORIA POINT

OPW NUMBER:	OPW /
LGA:	REDLAND CITY COUNCIL
SUBURB:	VICTORIA POINT
ORIGIN:	MGA
SCALE:	1:250
DATUM:	AHD
DATE OF SURVEY:	28/02/2023
SURVEYED BY:	LAWSON SURVEYS
DRAWN BY:	QSD
CLIENT:	URBEX
ISSUE	D
PLAN REFERENCE:	20361B-3-WATER
SHEET	5 OF 5